

STATE ENGINEER
Salem, Oregon

MAR 5518 Well Record

STATE WELL NO. 6/3W-36F
COUNTY Marion
APPLICATION NO. GR-3618

OWNER: Leonard N. Hays


MAILING ADDRESS: 5600 Quinaby Road

LOCATION OF WELL: Owner's No.

CITY AND STATE: Salem, Oregon

SE 1/4 NW 1/4 Sec. 36 T. 6 S., R. 3 W., W.M.

Bearing and distance from section or subdivision corner 31.84 ch. S. 10° 51' W. from 1/4 cor. on the N. line of Sec. 36

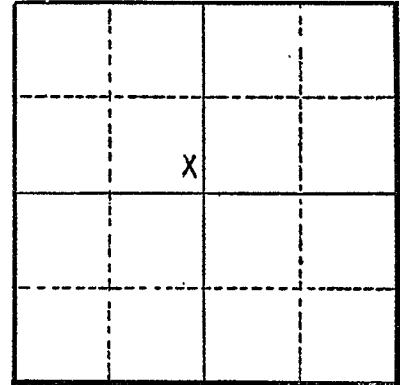

Section 36

Altitude at well

TYPE OF WELL: Drilled Date Constructed Nov., 1947

Depth drilled 44 feet Depth cased 44 feet

CASING RECORD:

6 inch steel casing set to 44 feet

FINISH:

AQUIFERS:

WATER LEVEL:

16 feet below surface

PUMPING EQUIPMENT: Type Montgomery Ward H.P. 2

Capacity 36 G.P.M.

WELL TESTS:

Drawdown 23 ft. after 36 hours G.P.M.

Drawdown ft. after hours G.P.M.

USE OF WATER irrigation Temp. °F. 19

SOURCE OF INFORMATION Well Registration Statement

DRILLER or DIGGER Clement of Gervais, Oregon

ADDITIONAL DATA:

Log Water Level Measurements Chemical Analysis Aquifer Test

REMARKS: