

MAR 55/5

Well Record

STATE WELL NO. 6/3W-36G(1)
COUNTY Marion
APPLICATION NO. GR-35

OWNER: Grover C. Gillespie


MAILING ADDRESS: 5750 Quinaby Road

LOCATION OF WELL: Owner's No.

CITY AND STATE: Salem, Oregon

SW 1/4 NE 1/4 Sec. 36 T. 6 N. S. R. 3 E. W., W.M.

Bearing and distance from section or subdivision corner 400 feet East of Quinaby Road and 150 feet North of south boundary of property

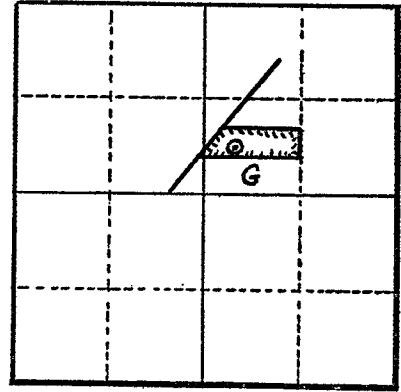

Section 36

Altitude at well 180 feet interpolated

TYPE OF WELL: Drilled Date Constructed May 1953

Depth drilled 60 feet Depth cased

CASING RECORD:

8-inch casing set depth unknown

FINISH:

none

AQUIFERS:

gravel from 8 to 60 feet

WATER LEVEL:

20 feet below land surface July 1954

PUMPING EQUIPMENT: Type Centrifugal H.P. 18
Capacity 250 G.P.M.

WELL TESTS:

Drawdown ft. after hours G.P.M.
Drawdown ft. after hours G.P.M.

USE OF WATER Irrigation 8 Temp. °F. 19

SOURCE OF INFORMATION GR-30

DRILLER or DIGGER

ADDITIONAL DATA:

Log x Water Level Measurements Chemical Analysis Aquifer Test

REMARKS:

Clay 0 to 8 feet 8
Sand & gravel 8 to 60 feet 52