

STATE ENGINEER
Salem, Oregon

5522

Well Record

STATE WELL NO. 6/3W-36M(1)
COUNTY Marion
APPLICATION NO. GR-1582

GR- 1529

OWNER: A. Burr & Elsa Pearl Black


MAILING ADDRESS: 2270 Chemawa Rd.

LOCATION OF WELL: Owner's No.

CITY AND STATE: Salem, Oregon

NW 1/4 SW 1/4 Sec. 36 T. 6 S., R. 3 W., W.M.

Bearing and distance from section or subdivision corner 201' S. & 114' E. from NE cor. W. P. Pugh
DLC. #41.

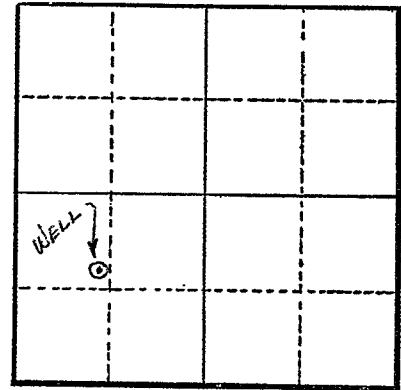

Section 36

Altitude at well 170' ? 150'

TYPE OF WELL: Drilled Date Constructed 1944

Depth drilled 50' Depth cased 50'

CASING RECORD:

5"

FINISH:

AQUIFERS:

WATER LEVEL:

18'

PUMPING EQUIPMENT: Type Homart jet

H.P. 1

Capacity 35 G.P.M.

WELL TESTS:

Drawdown ft. after hours G.P.M.

Drawdown ft. after hours G.P.M.

USE OF WATER Irrigation Temp. °F. 19

SOURCE OF INFORMATION GR Record

DRILLER or DIGGER

ADDITIONAL DATA:

Log N.A. Water Level Measurements Chemical Analysis Aquifer Test

REMARKS:

Irrigation of 6 acres.

Probably sanded to 34' now.