

STATE ENGINEER
Salem, Oregon

5523 Well Record

STATE WELL NO. 6/3W - 36M (2)
COUNTY MARION
APPLICATION NO. GR-1970

OWNER: Andrew Goldsby

MAILING ADDRESS:

2215 Chemawa Rd.,


LOCATION OF WELL: Owner's No.

CITY AND STATE:

Salem, Oregon

NW 1/4 SW 1/4 Sec. 36 T. 6 S., R. 3 W., W.M.

Bearing and distance from section or subdivision corner 6.44 Chs. E. & 6 chs. S. of W 1/4

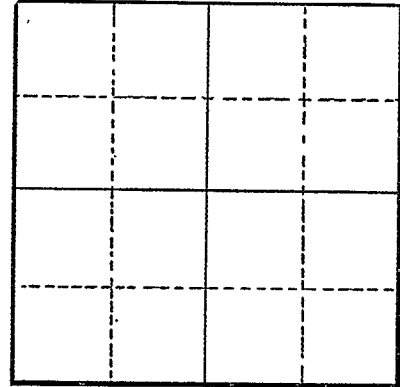

Section

Altitude at well 152'

TYPE OF WELL: Drilled Date Constructed 1949

Depth drilled 55 Depth cased 55

CASING RECORD:

8-inch

FINISH:

Perforation from 43 to 55

AQUIFERS:

Unknown

WATER LEVEL:

18-feet

PUMPING EQUIPMENT: Type Fairbanks Morse Centrifugal H.P. 5
Capacity 160 G.P.M.

WELL TESTS:

Drawdown ft. after hours G.P.M.
Drawdown ft. after hours G.P.M.

USE OF WATER Irrigation - 16 acres Temp. °F., 19.....

SOURCE OF INFORMATION GR-1898

DRILLER or DIGGER Max T. Wymore

ADDITIONAL DATA:

Log Water Level Measurements Chemical Analysis Aquifer Test

REMARKS:

Unknown