

MARI... 5528

31st 2

File Original and First Copy with the STATE ENGINEER, SALEM, OREGON

WATER WELL REPORT STATE OF OREGON

State Well No. 6/3W-36 NW State Permit No. GR-2941

(1) OWNER:

Name HAROLD RICHARDSON Address 1820 CHEMURA ROAD SALEM ORE.

(2) LOCATION OF WELL:

County MARION Owner's number, if any-- SW 1/4 SW 1/4 Section 36 T. 6S R. 3W W.M. Bearing and distance from section or subdivision corner

See attached map. 325 feet North & 520 feet East from SW 1/4 Section 36.

(3) TYPE OF WORK (check):

New Well X Deepening Reconditioning Abandonment Describe material and procedure in Item 11.

(4) PROPOSED USE (check):

Domestic Industrial Municipal Irrigation X Test Well Other

(5) TYPE OF WELL:

Rotary Cable Dug Driven Jetted Bored

(6) CASING INSTALLED:

8" Diam. from 1 ft. to 62 ft. Gage 1/4"

(7) PERFORATIONS:

Perforated? Yes X No Type of perforator used MILLS TYPE SIZE of perforations in. by in. 176 perforations from 3 1/2 ft. to 5 1/2 ft.

(8) SCREENS:

Well screen installed Yes X No Manufacturer's Name Type Model No. Slot size Set from ft. to ft. Diam. Slot size Set from ft. to ft.

(9) CONSTRUCTION:

Was well gravel packed? Yes X No Size of gravel: Gravel placed from ft. to ft. Was a surface seal provided? Yes X No To what depth? 8" Material used in seal-- PUMP Did any strata contain unusable water? Yes X No Type of water? Depth of strata Method of sealing strata off BACK FILLED

(10) WATER LEVELS:

Static level 14' 6" ft. below land surface Date 5-28-53 Artesian pressure lbs. per square inch Date

Log Accepted by:

[Signed] H. Richardson Date 7-11, 1958 (Owner)

(11) WELL TESTS:

Drawdown is amount water level is lowered below static level. Was a pump test made? Yield: gal./min. with ft. drawdown after hrs. Baller test 180 gal./min. with 24 ft. drawdown after 2 hrs. Artesian flow g.p.m. Date Temperature of water Was a chemical analysis made? Yes X No

(12) WELL LOG:

Diameter of well 8 1/2 inches. Depth drilled 62 ft. Depth of completed well 62 ft. Formation: Describe by color, character, size of material and structure, and show thickness of aquifers and the kind and nature of the material in each stratum penetrated, with at least one entry for each change of formation.

Table with columns: MATERIAL, FROM, TO. Rows: SUBSOIL (20-20), CEMENTED GRAVEL (7-27), SAND + GRAVEL #2 1/2 (10-37), SAND (3-40), CEMENTED GRAVEL (20-60), WATER GRAVEL (2-62)

Work started 5-26 1953 Completed 5-28 1953

(13) PUMP:

Manufacturer's Name Type: H.P.

Well Driller's Statement:

This well was drilled under my jurisdiction and this report is true to the best of my knowledge and belief.

NAME J.A. SNEED & SONS (Person, firm, or corporation) (Type or print)

Address 2505 BROOKS ST SALEM

Driller's well number

[Signed] J.A. Sneed (Well Driller)

License No. 6 Date 7-10, 1958

STATE ENGINEER  
Salem, Oregon

**MARI**  
**5528**  
**Well Record**

STATE WELL NO. 6/3W-36N  
COUNTY MARION  
APPLICATION NO. GR-2941

OWNER: Harold Richardson

MAILING ADDRESS: 1820 Chemawa Rd


LOCATION OF WELL: Owner's No. \_\_\_\_\_

CITY AND STATE: Oregon

B 2 of 2

SW 1/4 SW 1/4 Sec. 36 T. 6 S., R. 3 W., W.M.

Bearing and distance from section or subdivision corner 325' N & 520' E from SW cor Sec 36

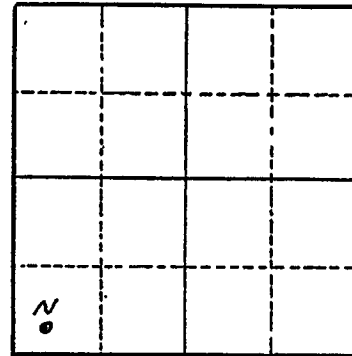

Section 36

Altitude at well \_\_\_\_\_

TYPE OF WELL: Drilled Date Constructed 1953

Depth drilled 62' Depth cased 62'

CASING RECORD:

8-inch

FINISH:

176 perforations 34' to 58'

AQUIFERS:

WATER LEVEL:

15'

PUMPING EQUIPMENT: Type Berkeley

H.P. 5

Capacity 100 G.P.M.

WELL TESTS:

Drawdown 24 ft. after \_\_\_\_\_ hours 100 G.P.M.

Drawdown \_\_\_\_\_ ft. after \_\_\_\_\_ hours \_\_\_\_\_ G.P.M.

USE OF WATER Irrigation Temp. \_\_\_\_\_ °F. \_\_\_\_\_, 19\_\_\_\_\_

SOURCE OF INFORMATION GR-3965

DRILLER or DIGGER \_\_\_\_\_

ADDITIONAL DATA:

Log \_\_\_\_\_ Water Level Measurements \_\_\_\_\_ Chemical Analysis \_\_\_\_\_ Aquifer Test \_\_\_\_\_

REMARKS: