

STATE ENGINEER  
Salem, Oregon

5571  
MARION

# Well Record

STATE WELL NO. 6/1-7P  
COUNTY Marion  
APPLICATION NO. GR-3376

App.#. G-2568 & G-4068

OWNER: Paul Dickman


MAILING ADDRESS: Route 1, Box 340

LOCATION OF WELL: Owner's No.

CITY AND STATE: Silverton, Oregon

SE 1/4 SW 1/4 Sec. 7 T. 6 S., R. 1 E. W.M.

Bearing and distance from section or subdivision corner 250' N. and 450' W.

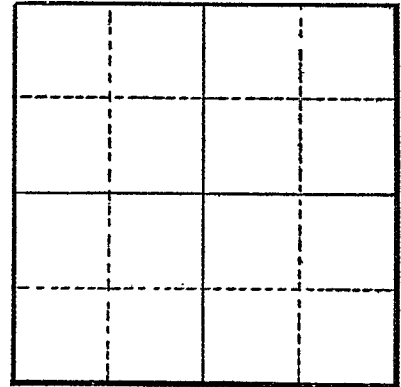

Section

Altitude at well

TYPE OF WELL: drilled Date Constructed 1948

Depth drilled 76' Depth cased 66'

### CASING RECORD:

8"

### FINISH:

not cased below 66'

### AQUIFERS:

### WATER LEVEL:

6'

PUMPING EQUIPMENT: Type Berkeley Turbine H.P. 18  
Capacity G.P.M.

### WELL TESTS:

Drawdown ft. after hours pumping 50 G.P.M.

Drawdown ft. after hours G.P.M.

USE OF WATER Irrigation Temp. °F., 19

SOURCE OF INFORMATION GR-3120

DRILLER or DIGGER R. Stadel, Route 3, Silverton, Oregon

### ADDITIONAL DATA:

Log Water Level Measurements Chemical Analysis Aquifer Test

### REMARKS: