

STATE ENGINEER
Salem, Oregon

MARI 5622

Well Record

GR- 1028

STATE WELL NO. 6/1-17F(1)
COUNTY Marion
APPLICATION NO. GR- 1066

OWNER: Leslie Brown


MAILING ADDRESS: RT. 1, BOX 343

LOCATION OF WELL: Owner's No.

CITY AND STATE: Silverton, Oregon

SE 1/4 NW 1/4 Sec. 17 T. 6 S., R. 1 E., W.M.

Bearing and distance from section or subdivision corner 1750 E. & 100' N. from W 1/4 cor. Sec. 17.

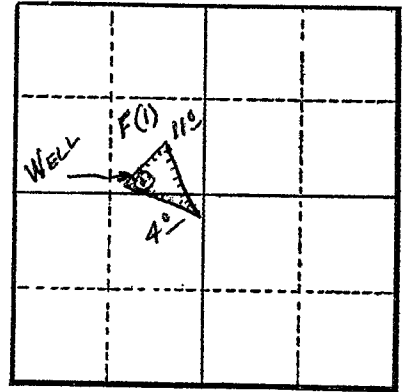

Section 17

Altitude at well

TYPE OF WELL: Drilled Date Constructed 1948

Depth drilled 108 ft. Depth cased 17

CASING RECORD:

6 inch

FINISH:

AQUIFERS:

WATER LEVEL:

35 ft.

PUMPING EQUIPMENT: Type Jacuzzi Jet

H.P. 5

Capacity 100 G.P.M.

WELL TESTS:

Drawdown ft. after hours G.P.M.

Drawdown ft. after hours G.P.M.

USE OF WATER Irrigation Temp. °F. 19

SOURCE OF INFORMATION G.R. Record

DRILLER or DIGGER R. Stadel

ADDITIONAL DATA:

Log Water Level Measurements Chemical Analysis Aquifer Test

REMARKS:

Log: Top soil 0 to 17 ft.
Basalt 17 to 108 ft.

Irrigation of 15 acres.