

STATE ENGINEER  
Salem, Oregon

*MAR 15 1962*  
**Well Record**

STATE WELL NO. 6/1-17M  
COUNTY MARION  
APPLICATION NO. GR-2706

OWNER: E. L. Fennimore


MAILING ADDRESS: Rt. 1, Box 345 Silverton

LOCATION OF WELL: Owner's No. \_\_\_\_\_

CITY AND STATE: Oregon

NW 1/4 SW 1/4 Sec. 17 T. 6 N. S. R. 1 E. W.M.

Bearing and distance from section or subdivision corner 1600' N. and 150' E.

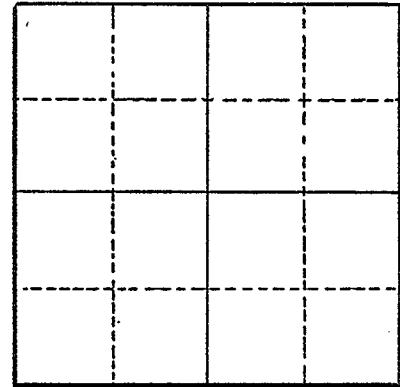

Section 3

Altitude at well \_\_\_\_\_

TYPE OF WELL: drilled Date Constructed 1944

Depth drilled 82 Depth cased 3

CASING RECORD:

6-inch

FINISH:

AQUIFERS:

Rock

WATER LEVEL:

40-feet

PUMPING EQUIPMENT: Type Jacuzzi Submersible H.P. 1 1/2

Capacity 30 G.P.M.

WELL TESTS:

Drawdown 25 ft. after \_\_\_\_\_ hours Pumping 30 G.P.M.

Drawdown \_\_\_\_\_ ft. after \_\_\_\_\_ hours \_\_\_\_\_ G.P.M.

USE OF WATER Irrigation Temp. \_\_\_\_\_ °F. \_\_\_\_\_, 19\_\_\_\_\_

SOURCE OF INFORMATION GR-2562

DRILLER or DIGGER S. Nickelson

ADDITIONAL DATA:

Log  Water Level Measurements \_\_\_\_\_ Chemical Analysis \_\_\_\_\_ Aquifer Test \_\_\_\_\_

REMARKS:

Bed rock 3 to 82