

STATE ENGINEER
Salem, Oregon

Well Record

STATE WELL NO. 4/1W-17R
COUNTY Marion
APPLICATION NO. GR-1789

GR- 1731

OWNER: Raymond Gilles

MAILING

ADDRESS: Rt. 1, Box 228

LOCATION OF WELL: Owner's No.

CITY AND

STATE: Aurora, Oregon

SE 1/4 SE 1/4 Sec. 17 T. 4 S. R. 1 W., W.M.

Bearing and distance from section or subdivision

corner 693' E. & 924' N. from SE cor. Sec. 17


Altitude at well 180'

TYPE OF WELL: Drilled Date Constructed 1955

Depth drilled 104' Depth cased 104'

CASING RECORD:

8"

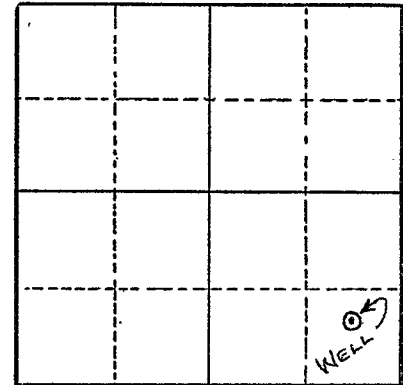

Section 17

FINISH:

Torch cut perforations: 16" x 1/8" (100 total) from 60 to 104 ft.

AQUIFERS:

WATER LEVEL:

20'

PUMPING EQUIPMENT: Type Layne & Bowler

H.P. 15

Capacity 275 G.P.M.

WELL TESTS:

Drawdown ft. after hours G.P.M.

Drawdown ft. after hours G.P.M.

USE OF WATER Irrigation

Temp. °F. 19

SOURCE OF INFORMATION GR Record

DRILLER or DIGGER

ADDITIONAL DATA:

Log Water Level Measurements Chemical Analysis Aquifer Test

REMARKS:

Log: Top soil 0 to 4 ft.
Brown clay 4 to 28 ft.
Sandy blue clay 28 to 67 ft.
Brown clay 67 to 74 ft.
Sand & small gravel 74 to 94 ft.
Sand & large gravel 94 to 104 ft.

Irrigation of 31.7 acres.