

STATE ENGINEER  
Salem, Oregon

# Well Record

STATE WELL NO. 6/1-19E  
COUNTY Marion  
APPLICATION NO. GR-1838

MARION 5679

GR- 1783

OWNER: Maurice Nissen


MAILING ADDRESS: Rt. 1, Box 360

LOCATION OF WELL: Owner's No. \_\_\_\_\_

CITY AND STATE: Silverton, Oregon

SW  $\frac{1}{4}$  NW  $\frac{1}{4}$  Sec. 19 T. 6 N S., R. 1 W, W.M.

Bearing and distance from section or subdivision corner 1138' E. & 1660' S. from NW cor. Sec. 19

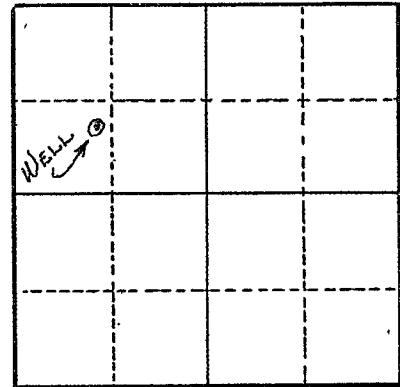

Section 19

Altitude at well \_\_\_\_\_

TYPE OF WELL: Drilled Date Constructed 1953

Depth drilled 107' Depth cased 93'

CASING RECORD:  
8"

FINISH:

AQUIFERS:

WATER LEVEL:  
17'

PUMPING EQUIPMENT: Type Universal jet H.P. 2  
Capacity 50 G.P.M.

WELL TESTS:  
Drawdown 50 ft. after 100 hours          G.P.M.  
Drawdown 35 ft. after 70 hours          G.P.M.

USE OF WATER Irrigation Temp.          °F.         , 19

SOURCE OF INFORMATION GR Record

DRILLER or DIGGER \_\_\_\_\_

ADDITIONAL DATA:  
Log \_\_\_\_\_ Water Level Measurements \_\_\_\_\_ Chemical Analysis \_\_\_\_\_ Aquifer Test \_\_\_\_\_

REMARKS:

Log: Top soil, brown 0 to 2 ft.  
Cobble stone & dirt 2 to 20 ft.  
Cemented gravel & some larger stones mixed 20 to 107 ft.  
Bottom 14' is filled with coarse gravel

Irrigation of 10.68 acres.