

STATE ENGINEER  
Salem, Oregon

**573 Well Record**  
MARION.....

STATE WELL NO. 4/1W-17N  
COUNTY Marion  
APPLICATION NO. GR-3157

OWNER: Sid and Mildred Hendricks

MAILING ADDRESS: R.F.D. 1


Pg 1 of 2

LOCATION OF WELL: Owner's No. ....

CITY AND STATE: Aurora, Oregon

SW ¼ SW ¼ Sec. 17 T. 4 S., R. 1 W., W.M.

Bearing and distance from section or subdivision corner 1200' N. and 600' E.

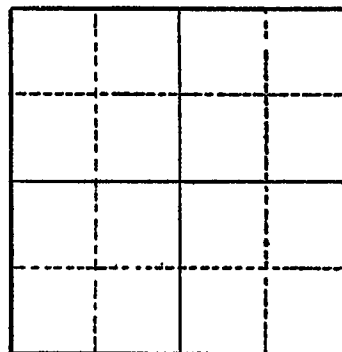

Section .....

Altitude at well .....

TYPE OF WELL: DRILLED Date Constructed 1951  
122' 122'

Depth drilled ..... Depth cased .....

CASING RECORD:

6"

FINISH:

AQUIFERS:

WATER LEVEL:

37'

PUMPING EQUIPMENT: Type Advance Jet H.P. 3  
Capacity 90 G.P.M.

WELL TESTS:

Drawdown 14 ft. after ..... hours pumping 150 G.P.M.  
Drawdown ..... ft. after ..... hours ..... G.P.M.

USE OF WATER Irrigation Temp. .... °F. ...., 19.....

SOURCE OF INFORMATION GR-2956

DRILLER or DIGGER Andrus, Kaiser District Salem, Oregon

ADDITIONAL DATA:

Log ..... Water Level Measurements ..... Chemical Analysis ..... Aquifer Test .....

REMARKS:

STATE ENGINEER  
Salem, Oregon

MARI 573

# Well Record

STATE WELL NO. 4/1W-17N(2)  
COUNTY Marion  
APPLICATION NO. GR 2951

OWNER: Sid Hendricks


MAILING ADDRESS:  
CITY AND STATE:

Pg 2 of 2

LOCATION OF WELL: Owner's No.

..... 1/4 ..... 1/4 Sec. .... T. .... N. S, R. .... E. W., W.M.

Bearing and distance from section or subdivision corner

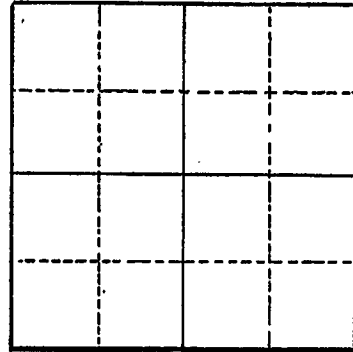

Section

Altitude at well 190

TYPE OF WELL: Drilled Date Constructed 1951

Depth drilled 122 Depth cased 122

### CASING RECORD:

6 inch

### FINISH:

Open bottom (casing unperforated)

### AQUIFERS:

### WATER LEVEL:

37 feet below land surface, June, 1951

PUMPING EQUIPMENT: Type Jet H.P. 3  
Capacity G.P.M.

### WELL TESTS:

Drawdown ft. after hours G.P.M.  
Drawdown ft. after hours G.P.M.

USE OF WATER Domestic, Irrigation-8 ac. Temp. °F. 19

SOURCE OF INFORMATION USGS

DRILLER or DIGGER

### ADDITIONAL DATA:

Log Water Level Measurements Chemical Analysis Aquifer Test

### REMARKS: