

STATE ENGINEER
Salem, Oregon

574
MARION

Well Record

STATE WELL NO. 4/1W-17N(1)
COUNTY Marion
APPLICATION NO.

OWNER: E. W. Christopherson


MAILING ADDRESS:

LOCATION OF WELL: Owner's No.

CITY AND STATE:

..... 1/4 1/4 Sec. T. N. S., R. E. W., W.M.

Bearing and distance from section or subdivision corner

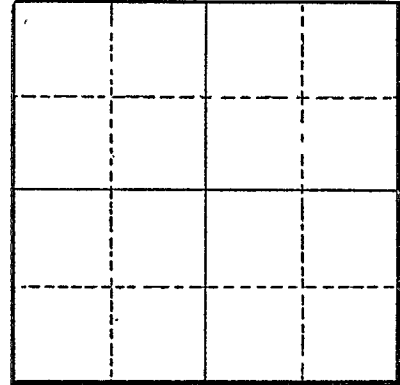

Section

Altitude at well 190

TYPE OF WELL: Drilled Date Constructed 1950

Depth drilled 86 Depth cased

CASING RECORD:

8 inch

FINISH:

Open bottom (casing unperforated)

AQUIFERS:

Gravel

WATER LEVEL:

28.10 feet below land surface on February 3, 1960

PUMPING EQUIPMENT: Type Jet

H.P.

Capacity G.P.M.

WELL TESTS:

Drawdown ft. after hours G.P.M.

Drawdown ft. after hours G.P.M.

USE OF WATER Domestic, Irrigation Temp. °F., 19

SOURCE OF INFORMATION USGS

DRILLER or DIGGER

ADDITIONAL DATA:

Log Water Level Measurements Chemical Analysis Aquifer Test

REMARKS: