

STATE ENGINEER  
Salem, Oregon

5588  
M 171...86

# Well Record

STATE WELL NO. 6/1-26E(1)  
COUNTY Marion  
APPLICATION NO. GR-30

OWNER: J. H. Bielenberg

MAILING  
ADDRESS:

LOCATION OF WELL: Owner's No.

CITY AND

STATE: Scotts Mills, Oregon


SW 1/4 NW 1/4 Sec. 26 T. 6 N. S. R. 1 E. W.M.

Bearing and distance from section or subdivision

corner Lot 28, Friends Oregon Colony and Lot 29

14, and 15 Well is 100 feet North and 85 feet

East of tree in NW Corner, Lot 28

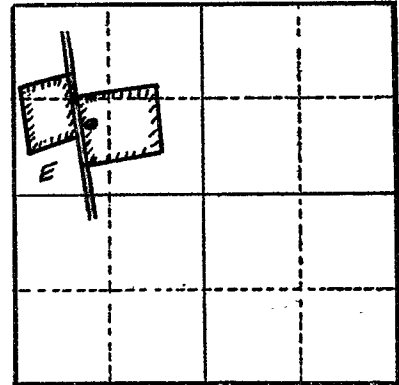

Altitude at well 700 feet interpolated

Section 26

TYPE OF WELL: Drilled Date Constructed Oct. 1954

Depth drilled 330 feet Depth cased 47 feet

## CASING RECORD:

10-inch casing set from 0 to 47 feet

## FINISH:

none

## AQUIFERS:

## WATER LEVEL:

100 feet below land surface Oct. 1955

PUMPING EQUIPMENT: Type Berkeley 6-8" stage H.P. 5  
Capacity 50 G.P.M.

## WELL TESTS:

Drawdown 100 ft. after 50 hours G.P.M.

Drawdown ft. after hours G.P.M.

USE OF WATER Irrigation & Domestic (30) Temp. °F. 19

SOURCE OF INFORMATION GR-34

DRILLER or DIGGER Harrely Bros., Hillsboro, Oregon

## ADDITIONAL DATA:

Log no Water Level Measurements Chemical Analysis Aquifer Test

## REMARKS: