


STATE OF OREGON
WATER SUPPLY WELL REPORT
(as required by ORS 537.765)

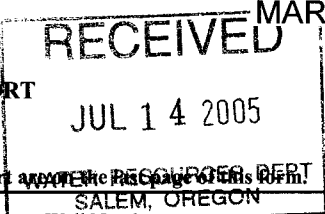

WELL I.D. # L 77203
START CARD # 172095

Instructions for completing this report are on the back page of this form!

(1) LAND OWNER
Name Macleay Christian Retreat
Address 2887 74th SE
City Salem State OR Zip 97301

(2) TYPE OF WORK New Well
 Deepening Alteration (repair/recondition) Abandonment Conversion

(3) DRILL METHOD
 Rotary Air Rotary Mud Cable Auger Cable Mud
 Other Welder

(4) PROPOSED USE
 Domestic Community Industrial Irrigation
 Thermal Injection Livestock Other

(5) BORE HOLE CONSTRUCTION Special Construction: Yes No
Depth of Completed Well _____ ft.
Explosives used: Yes No Type _____ Amount _____

BORE/HOLE SEAL
Diameter from To Seal from To Sacks or Pounds
No Change

How was seal placed: Method A B C D E
 Other _____
Backfill placed from _____ ft. to _____ ft. Material _____
Gravel placed from _____ ft. to _____ ft. Size of gravel _____

(6) CASING/LINER
Diameter From To Gauge Steel Plastic Welded Threaded
Casing: 8x6 46.5 + 2ft
Liner: 4x4

Drive Shoe used Inside Outside None
Final location of shoe(s) _____

(7) PERFORATIONS/SCREENS
 Perforations Method _____
 Screens Type _____ Material _____
From To Slot Number Diameter Tele/pipe Casing Liner
Size Number size size
No Change

(8) WELL TESTS: Minimum testing time is 1 hour
 Pump Bailer Air Flowing Artesian
Yield gal/min Drawdown Drill stem at Time
No Change
Temperature of water _____ Depth Artesian Flow Found _____
Was a water analysis done? Yes By whom _____
Did any strata contain water not suitable for intended use? Too little
 Salty Muddy Odor Colored Other _____
Depth of strata: _____

(9) LOCATION OF WELL (legal description)
County Marion
Tax Lot 800 Lot _____
Township 8 S N or S Range 2 W E or W WM
Section 3 NE 1/4 SE 1/4
Lat _____ " or _____ (degrees or decimal)
Long _____ " or _____ (degrees or decimal)
Street Address of Well (or nearest address) 2887 74th Ave. SE, Salem, OR 97301

(10) STATIC WATER LEVEL
22ft ft. below land surface. Date 06/29/2005
_____ ft. below land surface. Date _____
Artesian pressure _____ lb. per square inch Date _____

(11) WATER BEARING ZONES
Depth at which water was first found _____
From To Estimated Flow Rate SWL
No Change
22ft

(12) WELL LOG
Ground Elevation _____
Material From To SWL
6" x 8" Reducer
Welded to Top
Beier & Waldroop
Well Services Inc.
503-792-5925

Date Started 06/29/2005 Completed 06/29/2005

(unbonded) Water Well Constructor Certification
I certify that the work I performed on the construction, deepening, alteration, or abandonment of this well is in compliance with Oregon water supply well construction standards. Materials used and information reported above are true to the best of my knowledge and belief.

WWC Number _____ Date _____
Signed _____

(bonded) Water Well Constructor Certification
I accept responsibility for the construction, deepening, alteration, or abandonment work performed on this well during the construction dates reported above. All work performed during this time is in compliance with Oregon water supply well construction standards. This report is true to the best of my knowledge and belief.
WWC Number 561 Date 06/29/2005
Signed Dallas Edwin