

MARI 59721

MARI 59721

STATE OF OREGON
WATER SUPPLY WELL REPORT
(as required by ORS 537.765 & OAR 690-205-0210)

06-01-2006

WELL LABEL # L 82772

START CARD # 181434

Amended

(1) LAND OWNER Owner Well I.D. Well # 8

First Name Last Name
Company City of Newberg
Address 414 E 1st Street
City Newberg State OR Zip 97132

(2) TYPE OF WORK
New Well Deepening Conversion
Alteration (repair/recondition) Abandonment

(3) DRILL METHOD
Rotary Air Rotary Mud Cable Auger Cable Mud
Reverse Rotary Other

(4) PROPOSED USE
Domestic Irrigation Community
Industrial/ Commercial Livestock Dewatering
Thermal Injection Other

(5) BORE HOLE CONSTRUCTION Special Standard Attach copy/
Depth of Completed Well 100.00 ft.

Table with columns: Dia, From, To, Material, SEAL, Amt, lbs. Rows include Cement, Bentonite Chips, Cement.

How was seal placed: Method A B C D E
Backfill placed from 57 ft. to 53 ft. Material sugar sand
Filter pack from ft. to ft. Material Size
Explosives used: Yes Type Amount

(6) CASING/LINER
Table with columns: Casing, Liner, Dia, From, To, Gauge, Stl, Plstc, Wld, Thrd

Shoe Inside Outside Other Location of shoe(s)
Temp casing Yes Dia From To

(7) PERFORATIONS/SCREENS
Perforations Method
Screens Type Tele/wire wrap Material 304 stainless
Table with columns: Perf/, Casing/, Screen, Dia, From, To, Scrm/slot width, Slot length, # of slots, Tele/ pipe size

(8) WELL TESTS: Minimum testing time is 1 hour
Pump Bailer Air Flowing Artesian
Table with columns: Yield gal/min, Drawdown, Drill stem/Pump depth, Duration (hr)

Temperature 59 °F Lab analysis Yes By GSI
Water quality concerns? Yes (describe below)
Table with columns: From, To, Description, Amount, Units

(9) LOCATION OF WELL (legal description)

County Marion Twp 3.00 S N/S Range 2.00 W E/W WM
Sec 29 NE 1/4 of the SW 1/4 Tax Lot 100
Tax Map Number Lot
Lat ° 0 ' " or DMS or DD
Long ° 0 ' " or DMS or DD
Street address of well Nearest address

4500 Champoeg Road NE, St. Paul, OR

(10) STATIC WATER LEVEL Date SWL(psi) + SWL(ft)


Table with columns: Existing Well / Predeepening, Completed Well, Date, SWL(psi), SWL(ft)

Flowing Artesian? Dry Hole?
WATER BEARING ZONES Depth water was first found

Table with columns: SWL Date, From, To, Est Flow, SWL(psi), SWL(ft)

(11) WELL LOG Ground Elevation

Table with columns: Material, From, To
Silt w/ brown clay, Black and brown sand, Wood, Sand and Wood, Gravel and fine sands, Clay (brown / gray)

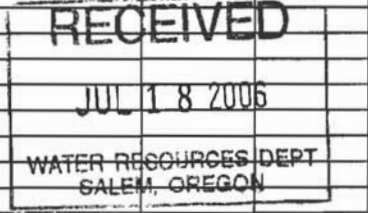

Date Started 03-28-2006 Completed 05-31-2006

(unbonded) Water Well Constructor Certification
I certify that the work I performed on the construction, deepening, alteration, or abandonment of this well is in compliance with Oregon water supply well construction standards.

License Number 1530 Date 06-01-2006
Electronically Filed
Signed STEVEN VIBBARD (E-filed)

(bonded) Water Well Constructor Certification
I accept responsibility for the construction, deepening, alteration, or abandonment work performed on this well during the construction dates reported above.

License Number 1464 Date 06-01-2006
Electronically Filed
Signed GREG MCINNIS (E-filed)
Contact Info (optional)