

STATE ENGINEER
Salem, Oregon

MARI... 600

Well Record

STATE WELL NO. 4/1W-18D
COUNTY Marion
APPLICATION NO. GR-2687

OWNER: Herschel R. Driever


MAILING ADDRESS: Route 1, Box 218

LOCATION OF WELL: Owner's No.

CITY AND STATE: Aurora, Oregon

NW 1/4 NW 1/4 Sec. 18 T. 4 N S, R. 1 W, W.M.

Bearing and distance from section or subdivision
corner 660' S. & 265' E.

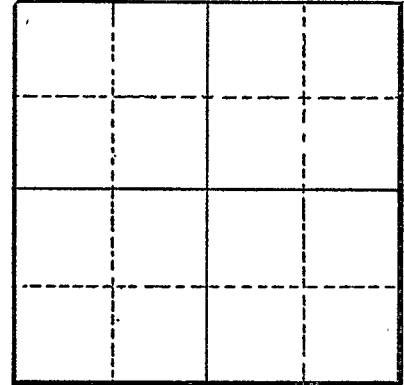

Section

Altitude at well

TYPE OF WELL: Drilled Date Constructed 1952

Depth drilled 92' Depth cased 90'

CASING RECORD:

10 inch

FINISH:

AQUIFERS:

sand, gravel and clay

WATER LEVEL:

3 feet

PUMPING EQUIPMENT: Type Peerless Turbine H.P. 10
Capacity 190 G.P.M.

WELL TESTS:

Drawdown ft. after hours pumping 180 G.P.M.
Drawdown ft. after hours G.P.M.

USE OF WATER irrigation Temp. °F. 19

SOURCE OF INFORMATION GR-2545

DRILLER or DIGGER J. T. Miller, Aurora, Oregon

ADDITIONAL DATA:

Log Water Level Measurements Chemical Analysis Aquifer Test

REMARKS:

course sand & gravel from 87 to 90
yellow clay 90 to 92