

(1) OWNER: Fred Scharer  
Name  
Address Rt. 2, Box  
Silverton, Oregon

(2) LOCATION OF WELL:  
County Marion Owner's number, if any--  
R. F. D. or Street No. Rt. 2, Box , Silverton, Ore.  
Bearing and distance from section or subdivision corner  
2300 ft. west & 800 ft. south of N.E. corner of Sec. 7, T. 7 S., R. 1 W.

(3) TYPE OF WORK (check):  
New well  Deepening  Reconditioning  Abandon   
If abandonment, describe material and procedure in Item 11.

(4) PROPOSED USE (check):  
Domestic  Industrial  Municipal   
Irrigation  Test Well  Other   
(5) EQUIPMENT:  
Rotary   
Cable   
Dug Well

(6) CASING INSTALLED:  
Threaded  Welded   
FROM ft. to ft. Diam. Gage or Wall  
" 0 " 172 " 8 " 4 "  
" " " " " "  
" " " " " "  
" " " " " "  
" " " " " "  
Type and size of shoe or well ring Describe joint Weld on type steel drive shoe  
Size of gravel:

(7) PERFORATIONS:  
Type of perforator used 8" Mills Perforator  
SIZE of perforations 3 in., length, by 1/4 in.  
FROM ft. to ft. perf per foot No. of rows  
" 80 " 105 " " 1 " " " 5 "  
" 112 " 119 " " 1 " " " 5 "  
" 120 " 123 " " 1 " " " 5 "  
" 135 " 136 " " 1 " " " 5 "  
1 SCREENS: 172 1 5  
Give Manufacturer's Name, Model No. and Size  
none

(8) CONSTRUCTION:  
Was a surface sanitary seal provided?  Yes  No To what depth 25 ft.  
Were any strata sealed against pollution?  Yes  No  
If yes, note depth of strata  
FROM ft. to ft.  
" " "  
METHOD OF SEALING concrete

(9) WATER LEVELS:  
Depth at which water was first found 85 ft.  
Standing level before perforating 60 ft.  
Standing level after perforating 43 ft.  
Log Accepted by:  
[Signed] Fred Scharer Dated 3/6, 1957  
Owner

(10) WELL TESTS: Stadeli Pump Service  
Was a pump test made?  Yes  No If yes, by whom?  
Yield: gal./min. with ft. draw down after hrs.  
" 160 " 122 " 5 "  
" " " " " "  
Artesian flow ..... g.p.m.  
Shut-in pressure ..... lbs. per square inch.  
Bailer test ..... g.p.m. with ..... ft. drawdown  
Temperature of water  Was a chemical analysis made?  Yes  No  
Was electric log made of well?  Yes  No

(11) WELL LOG:  
Diameter of well, 8 inches.  
Total depth 258 ft. Depth of completed well 258 ft.  
Formation: Describe by color, character, size of material and structure, and show thickness of aquifers and the kind and nature of the material in each stratum penetrated, with at least one entry for each change of formation.  
ft. to ft.  
0 " 4 " Top Soil-dark brown  
4 " 25 " Loam-brown  
25 " 65 " Clay-brown  
65 " 85 " Clay-grey  
85 " 105 " Cement gravel-grey (water)  
105 " 111 " Clay-grey  
111 " 119 " Cement gravel-blue (water)  
119 " 120 " Clay-brown  
120 " 123 " Cement gravel-grey (water)  
123 " 135 " Clay-brown  
135 " 136 " Gravel-blue & grey (water)  
136 " 160 " Clay-brown  
160 " 172 " Dirty gravel-grey (water)  
172 " 191 " Hard rock-dark grey  
191 " 257 " Hard rock-black  
257 " 258 " Hard rock-black (water)

Ground elevation at well site ..... 200 ..... feet above mean sea level.  
Work started Feb. 25, 1954. Completed Mar. 30, 1954

Well Driller's Statement:  
This well was drilled under my jurisdiction and this report is true to the best of my knowledge and belief.  
NAME R. Stadeli & Sons  
(Person, firm, or corporation) (Typed or printed)  
Address Rt. 3, Box 177A, Silverton, Oregon  
Driller's well number  
[Signed] Stadeli (Well Driller)  
License No. 84 Dated Sept. 16, 1955

STATE ENGINEER  
Salem, Oregon


MAR 28 1954  
WARI 6128  
Well Record

STATE WELL NO. 7/1W-7B(1)  
COUNTY Marion  
APPLICATION NO. GR-386

OWNER: Fred Scharer  
MAILING ADDRESS: Route 3, Box 134A

LOCATION OF WELL: Owner's No.  
CITY AND STATE: Silverton, Oregon

NW 1/4 NE 1/4 Sec. 7 T. 7 N. S. R. 1 E. W.M.  
Bearing and distance from section or subdivision  
corner 2250 feet West and 1000 feet South  
from NE Corner, Section 7

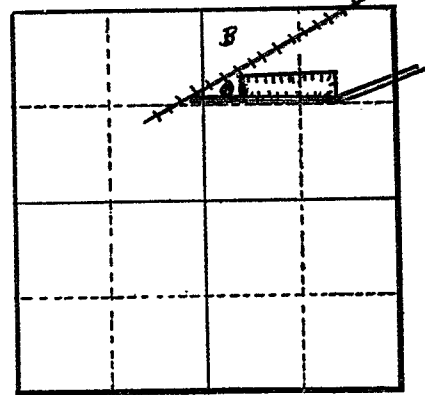

Section 7

Altitude at well

TYPE OF WELL: Drilled Date Constructed Apr. 1954

Depth drilled 258 feet Depth cased 172 feet

CASING RECORD:

8-inch

FINISH:

AQUIFERS:

WATER LEVEL:

43 feet

PUMPING EQUIPMENT: Type Jacuzzi Turbine H.P. 15  
Capacity 170 G.P.M.

WELL TESTS:

Drawdown ft. after hours G.P.M.  
Drawdown ft. after hours G.P.M.

USE OF WATER Irrigation 12 Temp. °F. 19

SOURCE OF INFORMATION GR-373  
DRILLER or DIGGER R. Stadeli & Sons

ADDITIONAL DATA:

Log  Water Level Measurements Chemical Analysis Aquifer Test

REMARKS:

