

STATE ENGINEER
Salem, Oregon

6156
MARI

OBSERVATION WELL
Well Record

STATE WELL NO. 7/1W-8J(1)
COUNTY Marion
APPLICATION NO. GR-30

OWNER: Edward A. Hari
MERLE KAUFMAN


MAILING ADDRESS: Route 3, Box 163

LOCATION OF WELL: Owner's No.

CITY AND STATE: Silverton, Oregon

SE 1/4 SE 1/4 Sec. 8 T. 7 S, R. 1 W., W.M.

Bearing and distance from section or subdivision
corner 20.02 chains west from SE Corner, Section 8

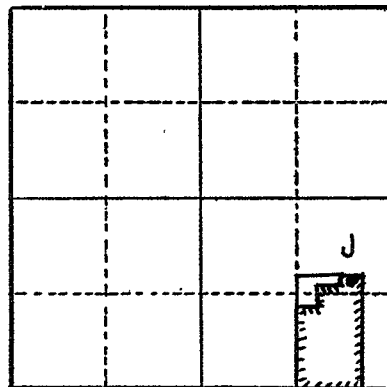

Altitude at well 195 feet interpolated

TYPE OF WELL: Drilled Date Constructed Feb. 1954

Depth drilled 309 feet Depth cased 18 feet

Section 8

CASING RECORD:

10-inch casing set from 0 to 18 feet in rock

FINISH:

none

AQUIFERS:

Basalt rock from 42 to 60 feet and from 140 to 160 feet

WATER LEVEL:

15 feet below land surface Feb. 1954

PUMPING EQUIPMENT: Type Jacuzzi, submersible (Jack) H.P. 7 1/2
Capacity 72 G.P.M.

WELL TESTS:

Drawdown 168 ft. after 72 hours G.P.M.

Drawdown ft. after hours G.P.M.

USE OF WATER Irrigation 22 acres Temp. °F., 19

SOURCE OF INFORMATION GR-26

DRILLER or DIGGER

ADDITIONAL DATA:

Log Water Level Measurements Chemical Analysis Aquifer Test

REMARKS:

