




MARI 61837

AS BUILT OF INSTALLED PACKER ON WELL L 22662

Westerberg Drilling, Inc.  
36728 S. Kropf Rd.  
Molalla, OR 97038

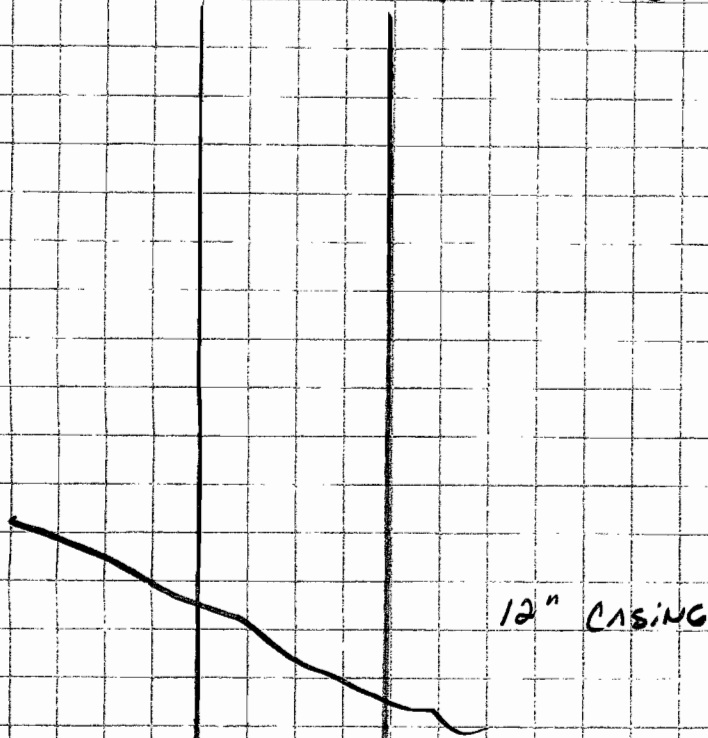

12" CASING

REDUCER FROM  $10\frac{3}{4}$ "  
OD / 10" I.D TO  
 $9\frac{1}{2}$ " OD / 9" I.D.  
THIS IS AT 164'  
B.L.S.

Top of 10" I.D. Packer 160'-10"  
BELOW LAND SURFACE

67 1/2"  
164'

Bottom of 9" I.D. / 9 1/2" O.D. Packer 166'-5 1/2"  
BELOW LAND SURFACE.

10" CASING

RECEIVED  
JUL 18 2008  
WATER RESOURCES DEPT  
SALEM, OREGON