

MARI 62640

STATE ENGINEER
Salem, Oregon

MARI
62640

Well Record

STATE WELL NO. 7/3W-26M(1)
COUNTY Marion
APPLICATION NO. GR-453

OWNER: California Packing Corp.


MAILING ADDRESS: 215 Fremont Street

LOCATION OF WELL: Owner's No.

CITY AND STATE: San Francisco, California

NW 1/4 SW 1/4 Sec. 26 T. 7 N. S., R. 3 E. W., W.M.

Bearing and distance from section or subdivision corner 1840 feet North and 325 feet East from the SW corner, Section 26

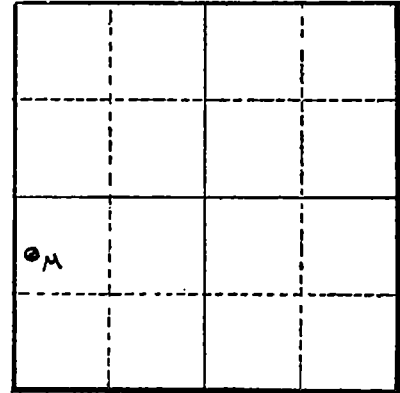

Section 26

Altitude at well 158.56 feet

TYPE OF WELL: Drilled Date Constructed July 15, 1947

Depth drilled 204 252 Depth cased 194

CASING RECORD:
12-inch

FINISH:

AQUIFERS:

WATER LEVEL:

30 feet

PUMPING EQUIPMENT: Type Peerless H.P. 60
Capacity 600 G.P.M.

WELL TESTS:

Drawdown 80 ft. after hours 600 G.P.M.
Drawdown 84 ft. after hours 566 G.P.M.

USE OF WATER Manufacturing Temp. °F. 19

SOURCE OF INFORMATION GR-438

DRILLER or DIGGER Southern Pacific Co., Salem, Oregon

ADDITIONAL DATA:

Log Water Level Measurements Chemical Analysis Aquifer Test

REMARKS:

