

STATE ENGINEER
Salem, Oregon

MAR 6 2 1945

Well Record


STATE WELL NO. 7/1W-16H(1)
COUNTY Marion
APPLICATION NO. GR-389

OWNER: Barnes Bros MAILING ADDRESS:

LOCATION OF WELL: Owner's No. CITY AND STATE: Silverton, Oregon

SE 1/4 NE 1/4 Sec. 16 T. 7 N. S. R. 1 W., W.M.

Bearing and distance from section or subdivision
corner 700 feet West and 920 feet North from
e/4 Corner, Section 16

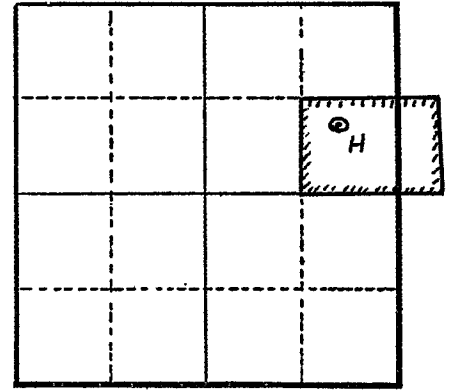

Section 16

Altitude at well 330 feet

TYPE OF WELL: Drilled Date Constructed 1946

Depth drilled 92 feet Depth cased 17 feet

CASING RECORD:

8-inch

FINISH:

AQUIFERS:

WATER LEVEL:
45 feet

PUMPING EQUIPMENT: Type Berkeley Turbine H.P. 10
Capacity 150 G.P.M.

WELL TESTS:
Drawdown ft. after hours G.P.M.
Drawdown ft. after hours G.P.M.

USE OF WATER Irrigation 50 Temp. °F., 19

SOURCE OF INFORMATION GR-376

DRILLER or DIGGER Studebaker Bros. Salem, Oregon

ADDITIONAL DATA:
Log Water Level Measurements Chemical Analysis Aquifer Test

REMARKS:

Dirt and boulders 0 17
Solid rock 17 92