

STATE ENGINEER
Salem, Oregon

Well Record

STATE WELL NO. 4/1W-19H(1)
COUNTY Marion
APPLICATION NO. GR-1061

MARION 631

GR- 1023

OWNER: Harland E. Feller

MAILING ADDRESS: Hubbard Rt. Box 378


LOCATION OF WELL: Owner's No. _____

CITY AND STATE: Hubbard, Oregon

SE 1/4 NE 1/4 Sec. 19 T. 4 S., R. 1 W., W.M.

Bearing and distance from section or subdivision

corner N84°13'E. 41.115 ch. from SW cor. Whitney
DIC #48

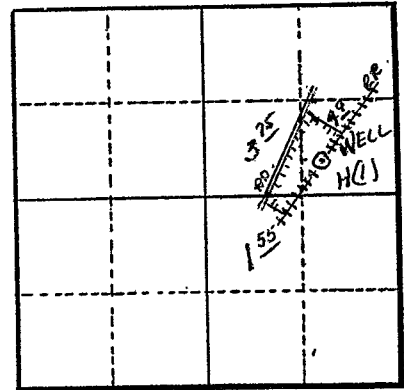

Section 19

Altitude at well 140 ft. ±

TYPE OF WELL: Drilled Date Constructed 1950

Depth drilled 120 ft. Depth cased 120 ft.

CASING RECORD:

6 5/8 inch

FINISH:

AQUIFERS:

WATER LEVEL:

45 ft.

PUMPING EQUIPMENT: Type Pacific Jet H.P. 5

Capacity 40 G.P.M.

WELL TESTS:

Drawdown 5 ft. after _____ hours 40 G.P.M.

Drawdown _____ ft. after _____ hours _____ G.P.M.

USE OF WATER Irrigation Temp. _____ °F., 19.

SOURCE OF INFORMATION G.R. Record

DRILLER or DIGGER _____

ADDITIONAL DATA:

Log Water Level Measurements _____ Chemical Analysis _____ Aquifer Test _____

REMARKS:

Irrigation of 10.2 acres.

