

STATE ENGINEER  
Salem, Oregon

632  
MARION


# Well Record

STATE WELL NO. 4/1W-19M(1)  
COUNTY Marion  
APPLICATION NO. GR-123

OWNER: A. H. Bekebrede  
MAILING ADDRESS: Route 1, Box 210

LOCATION OF WELL: Owner's No. 1  
CITY AND STATE: Aurora, Oregon

NW 1/4 SW 1/4 Sec. 19 T. 4 S., R. 1 W., W.M.  
Bearing and distance from section or subdivision  
corner 430' S. & 1200' E. from W1/4 cor. Sec. 19

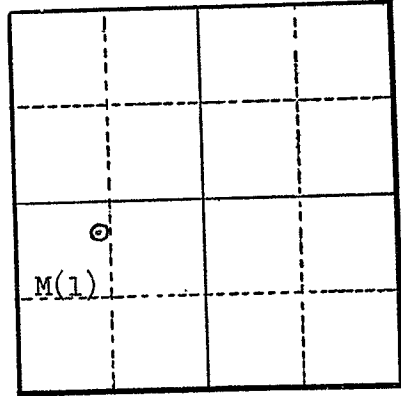

Altitude at well 160' Interpolated

TYPE OF WELL: Drilled Date Constructed 3/1/53

Depth drilled 130 Depth cased unknown

Section 19

### CASING RECORD:

No record

### FINISH:

No record

### AQUIFERS:

No record

### WATER LEVEL:

22 feet below land surface 3/9/53

PUMPING EQUIPMENT: Type Jacuzzi Turbine 9 stage H.P. 7 1/2  
Capacity 150 G.P.M.

WELL TESTS:  
Drawdown 58 ft. after 150 hours G.P.M.  
Drawdown 94 ft. after 450 hours G.P.M.

USE OF WATER Irrigation 20 acres Temp. °F., 19

SOURCE OF INFORMATION Registration Statement GR-123

DRILLER or DIGGER Wymore, Salem, Oregon

ADDITIONAL DATA:  
Log No Water Level Measurements Chemical Analysis Aquifer Test

### REMARKS: