

STATE ENGINEER  
Salem, Oregon

MAR 1936

# Well Record

STATE WELL NO. 7/1W-19M(1)  
COUNTY Marion  
APPLICATION NO. GR-121

OWNER: Wayne W. Chapman


MAILING ADDRESS:

LOCATION OF WELL: Owner's No.

CITY AND STATE: Salem, Oregon

NW ¼ SW ¼ Sec. 19 T. 7 N. R. 1 W., W.M.

Bearing and distance from section or subdivision corner 200 feet East and 1350 feet North from SW Corner, Section 19

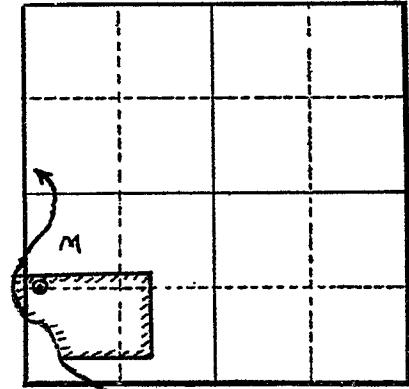

Section 19

Altitude at well 190 feet interpolated

TYPE OF WELL: Dug Date Constructed 6-1-54

Depth drilled 15 Depth cased

### CASING RECORD:

40 feet diameter sump no casing etc.

### FINISH:

none

### AQUIFERS:

unknown

### WATER LEVEL:

1½ feet below land surface

PUMPING EQUIPMENT: Type make not known H.P. 16

Capacity 500 G.P.M.

### WELL TESTS:

Drawdown ft. after hours G.P.M.

Drawdown ft. after hours G.P.M.

USE OF WATER Irrigation 33 Temp. °F., 19

SOURCE OF INFORMATION GR-112

DRILLER or DIGGER Salem Sand and Gravel Co. Gravel Pit (old)

### ADDITIONAL DATA:

Log Water Level Measurements Chemical Analysis Aquifer Test

### REMARKS:

topsoil	0	6
clay, blue	6	12
clay, yellow and rocks	12	15