

STATE ENGINEER  
Salem, Oregon

MARI 646


# Well Record

STATE WELL NO. 4/1W-20K(1)  
COUNTY Marion  
APPLICATION NO. GR-590

OWNER: Orrin W. Bliss  
MAILING ADDRESS: Route 1, Box 371

LOCATION OF WELL: Owner's No. \_\_\_\_\_  
CITY AND STATE: Hubbard, Oregon

NW 1/4 SE 1/4 Sec. 20 T. 4 N. S., R. 1 E. W., W.M.  
Bearing and distance from section or subdivision  
corner 1350' E. & 590' S. from E 1/4 cor. Sec. 20

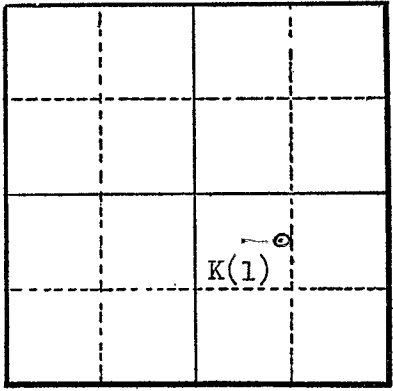

Section 20

Altitude at well 150

TYPE OF WELL: drilled Date Constructed 9-6-54

Depth drilled 94' 9" Depth cased 94' 9"

### CASING RECORD:

8 inch

### FINISH:

### AQUIFERS:

### WATER LEVEL:

29 feet

PUMPING EQUIPMENT: Type Fairbanks Morse "Pamona" H.P. 5  
Capacity 100 G.P.M.

### WELL TESTS:

Drawdown \_\_\_\_\_ ft. after \_\_\_\_\_ hours \_\_\_\_\_ G.P.M.  
Drawdown \_\_\_\_\_ ft. after \_\_\_\_\_ hours \_\_\_\_\_ G.P.M.

USE OF WATER Irrigation 16 acres Temp. \_\_\_\_\_ °F., 19

SOURCE OF INFORMATION GR-590

DRILLER or DIGGER J. T. Miller, Aurora, Oregon

### ADDITIONAL DATA:

Log \_\_\_\_\_ Water Level Measurements \_\_\_\_\_ Chemical Analysis \_\_\_\_\_ Aquifer Test \_\_\_\_\_

### REMARKS: