

STATE ENGINEER  
Salem, Oregon

(6495)  
MARI...25

# Well Record

STATE WELL NO. 7/2W-2F  
COUNTY MARION  
APPLICATION NO. GR-2663

OWNER: W. Edgar Nafziger


MAILING ADDRESS: Rt. 2, Box 536

LOCATION OF WELL: Owner's No.

CITY AND STATE: Salem, Oregon

SE 1/4 NW 1/4 Sec. 2 T. 7 N. S., R. 2 E. W.M.

Bearing and distance from section or subdivision corner E. 1403' & N. 150'

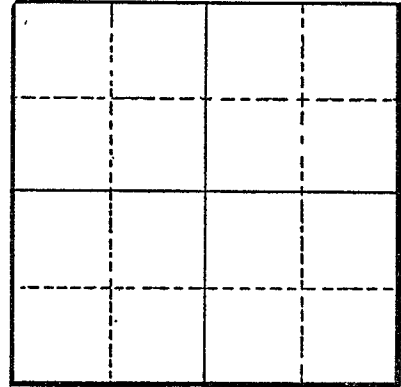

Section

Altitude at well

TYPE OF WELL: Drilled Date Constructed 1951

Depth drilled 139 Depth cased 139

### CASING RECORD:

10-inch

### FINISH:

4 perforations every 2' from 90' to 138'

### AQUIFERS:

Dirt, quick sand, clay, gravel and Hard pan

### WATER LEVEL:

30 1/2-feet

PUMPING EQUIPMENT: Type Berkeley Turbine H.P. 15  
Capacity 225 G.P.M.

### WELL TESTS:

Drawdown 55 1/2 ft. after hours Pumping 300 G.P.M.  
Drawdown 35 1/2 ft. after hours Pumping 200 G.P.M.

USE OF WATER Irrigation Temp. °F. 19

SOURCE OF INFORMATION GR-2525

DRILLER or DIGGER

### ADDITIONAL DATA:

Log X Water Level Measurements Chemical Analysis Aquifer Test

### REMARKS:

Dirt and quick sand	20	20
Blue clay	50	70
Yellow sand	10	80
Cement gravel	8	88
Water gravel	7	95
Sand and gravel	12	107
Loose gravel	3	110
Water gravel	10	120
Cement gravel	10	130
Hard pan	9	139

Clay