

STATE ENGINEER
Salem, Oregon

6512
MARI.....

Well Record

STATE WELL NO. 7/2W - 3B
COUNTY MARION
APPLICATION NO. GR-2280

OWNER: Pearl J. Dunigan


MAILING ADDRESS: Rt. 2, Box 508

LOCATION OF WELL: Owner's No.

CITY AND STATE: Salem, Oregon

NW 1/4 NE 1/4 Sec. 3 T. 7 N. S. R. 2 E. W., W.M.

Bearing and distance from section or subdivision corner 1980' W. of SE corner of Sec. 34, 1170' S. of SE corner of Sec. 34-765-R1W

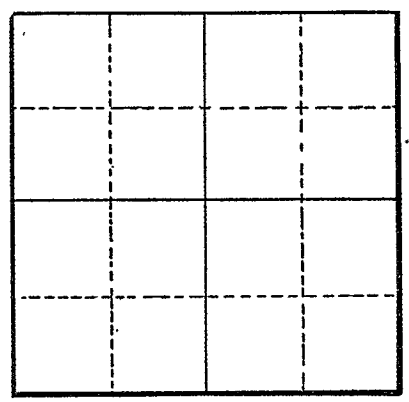

Section

Altitude at well

TYPE OF WELL: Drilled Date Constructed 1951

Depth drilled 117 Depth cased 117

CASING RECORD:

8-inch

FINISH:

AQUIFERS:

Sand & gravel

WATER LEVEL:

30-feet

PUMPING EQUIPMENT: Type General Electric Jet H.P. 1 1/2
Capacity 35 G.P.M.

WELL TESTS:

Drawdown ft. after hours G.P.M.
Drawdown ft. after hours G.P.M.

USE OF WATER Irrigation Temp. °F., 19

SOURCE OF INFORMATION GR-2174

DRILLER or DIGGER Studabaker Brothers

ADDITIONAL DATA:

Log Water Level Measurements Chemical Analysis Aquifer Test

REMARKS:

Sand & Gravel