

STATE ENGINEER
Salem, Oregon

6518
MARI.

Well Record


STATE WELL NO. 772W-3P
COUNTY Marion
APPLICATION NO. GR-2701

OWNER: Gilbert E. Haury
MAILING ADDRESS: Route 2, Box 518

LOCATION OF WELL: Owner's No.
CITY AND STATE: Salem, Oregon

SE 1/4 SW 1/4 Sec. 3 T. 7 N. S. R. 2 W. W.M.

Bearing and distance from section or subdivision
corner 1910 ft. E. and 850 ft. N.

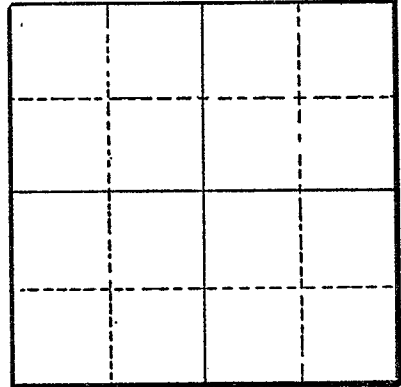

Section

Altitude at well

TYPE OF WELL: Drilled Date Constructed 1950

Depth drilled 100 Depth cased 100'

CASING RECORD:
6 inch

FINISH:

AQUIFERS:

WATER LEVEL:
45 feet

PUMPING EQUIPMENT: Type Berkeley Jet H.P. 3
Capacity 35 G.P.M.

WELL TESTS:
Drawdown 25 ft. after hours pumping 40 G.P.M.
Drawdown ft. after hours G.P.M.

USE OF WATER irrigation Temp. °F. 19

SOURCE OF INFORMATION GR-2559
DRILLER or DIGGER Stadley and Son., Silverton, Oregon

ADDITIONAL DATA:
Log Water Level Measurements Chemical Analysis Aquifer Test

REMARKS: