

STATE ENGINEER
Salem, Oregon

MAR 1953

Well Record

STATE WELL NO. 7/2W-5Q(1)
COUNTY Marion
APPLICATION NO.

OWNER: Burns Christofferson

MAILING ADDRESS:

P 1 of 2

LOCATION OF WELL: Owner's No.

CITY AND STATE:

..... 1/4 1/4 Sec. T. N. E.
S., R. W., W.M.

Bearing and distance from section or subdivision corner

Altitude at well 178

TYPE OF WELL: Drilled Date Constructed 1953

Depth drilled 90 Depth cased 90

Section

CASING RECORD:

8 inch

FINISH:

Casing perforated 60 to 90

AQUIFERS:

Sand from 45 to 90

WATER LEVEL:

17 feet below land surface on June 1, 1953

PUMPING EQUIPMENT: Type Turbine H.P. 15
Capacity G.P.M.

WELL TESTS:

Drawdown ft. after hours G.P.M.

Drawdown ft. after hours G.P.M.

USE OF WATER Irrigation 19 acres Temp. °F. , 19

SOURCE OF INFORMATION USGS

DRILLER or DIGGER

ADDITIONAL DATA:

Log Water Level Measurements Chemical Analysis Aquifer Test

REMARKS:

STATE ENGINEER
Salem, Oregon

MARION
6613

Well Record

STATE WELL NO. 7/2W-5D(1)
COUNTY Marion
APPLICATION NO. GR-754

OWNER: Burns & Ethel Christofferson

MAILING ADDRESS: 4420 Hood View Road


Page 2 of 2

LOCATION OF WELL: Owner's No. # 2

CITY AND STATE: Salem, Oregon

NW 1/4 NW 1/4 Sec. 5 T. 7 S., R. 2 W., W.M.

Bearing and distance from section or subdivision
corner 9.26 chains South and 71.63 chains West of
SE corner, Section 32.

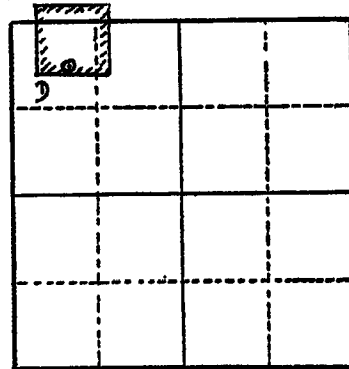

Altitude at well 178 feet interpolated

TYPE OF WELL: Drilled Date Constructed 1953

Depth drilled 90 feet Depth cased 90

Section 5

CASING RECORD:

8-inch casing from 0 to 90 feet

FINISH:

AQUIFERS:

WATER LEVEL:

17 feet

PUMPING EQUIPMENT: Type U.S. 3 phase Elect. Berkeley Deep Well H.P. 10

Capacity G.P.M.

WELL TESTS:

Drawdown 20 ft. after 500 hours G.P.M.

Drawdown ft. after hours G.P.M.

USE OF WATER Irrigation Temp. °F. 19

SOURCE OF INFORMATION GR-730

DRILLER or DIGGER

ADDITIONAL DATA:

Log Water Level Measurements Chemical Analysis Aquifer Test

REMARKS:

Willamette Loam	0	2	2
Clay	2	32	30
Sand	32	45	13
	45	90	45