

STATE ENGINEER
Salem, Oregon

10619.
MAR.

Well Record

STATE WELL NO. 7/2W-5D(1)
COUNTY Marion
APPLICATION NO.

OWNER: Pierre Saucy

MAILING ADDRESS:

LOCATION OF WELL: Owner's No.


CITY AND STATE:

1/4 1/4 Sec. T. N. S., R. E. W., W.M.

Bearing and distance from section or subdivision

corner

Altitude at well 184

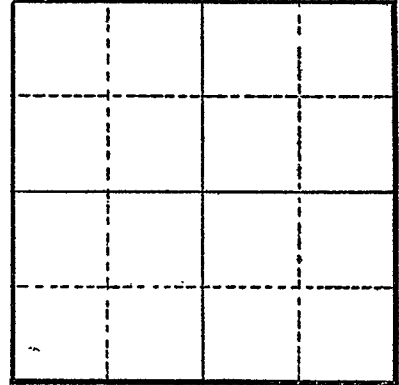

Section

TYPE OF WELL: Drilled Date Constructed 1958

Depth drilled 125 Depth cased 125

CASING RECORD:

10 inch

FINISH:

Casing perforated 61 to 66, 74 to 79, 90 to 125

AQUIFERS:

Brown and black sand and gravel from 58 to 79, and from 88 to 125

WATER LEVEL:

35 feet below land surface on July 6, 1958

PUMPING EQUIPMENT: Type Capacity G.P.M.

Turbine H.P. 30

WELL TESTS:

Drawdown ft. after hours G.P.M.

Drawdown ft. after hours G.P.M.

USE OF WATER Irrigation--50 acres Temp. °F., 19

SOURCE OF INFORMATION USGS

DRILLER or DIGGER

ADDITIONAL DATA:

Log Water Level Measurements Chemical Analysis Aquifer Test

REMARKS:

Temperature 56° F.

