

STATE ENGINEER
Salem, Oregon

6620
MARION

Well Record

STATE WELL NO. 7/2W-5E(1)
COUNTY Marion
APPLICATION NO. GR-175

OWNER: Anna M. Wulfemeyer


MAILING ADDRESS: 4645 Haysville Drive

LOCATION OF WELL: Owner's No.

CITY AND STATE: Salem, Oregon

SW 1/4 NW 1/4 Sec. 5 T. 7 N. S. R. 2 W., W.M.

Bearing and distance from section or subdivision corner 100 feet East and 150 feet North from W/4 corner, Section 5, Lot 10, Dorrance Fruit Farms

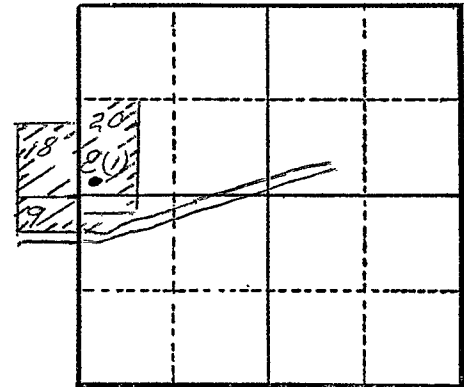

Section 5

Altitude at well 190 feet interpolated

TYPE OF WELL: Drilled Date Constructed 1941

Depth drilled 150 Depth cased

CASING RECORD:

12-inch casing unknown

FINISH:

unk

AQUIFERS:

unk

WATER LEVEL:

20 feet below land surface

PUMPING EQUIPMENT: Type Pomona Turbine 6" H.P. 7 1/2

Capacity 300 G.P.M.

WELL TESTS:

Drawdown ft. after hours G.P.M.

Drawdown ft. after hours G.P.M.

USE OF WATER Irrigation 50 Temp. °F., 19

SOURCE OF INFORMATION GR-165

DRILLER or DIGGER Myron West, Salem, Oregon

ADDITIONAL DATA:

Log no Water Level Measurements Chemical Analysis Aquifer Test

REMARKS: