

STATE ENGINEER  
Salem, Oregon

MAR 66 24  
MARI.....

# Well Record

STATE WELL NO. 7/2W-5K  
COUNTY MARION  
APPLICATION NO. GR-2576

OWNER: Cecil L. Reynolds


MAILING ADDRESS: 5085 Fletcher Road Pg 1 of 2

LOCATION OF WELL: Owner's No.

CITY AND STATE: Salem, Oregon

NW 1/4 SE 1/4 Sec. 5 T. 7 N S, R. 2 W, W.M.

Bearing and distance from section or subdivision corner S. 9° W. 36 chains & West 100' from NE corner  
John Martin DLG 71

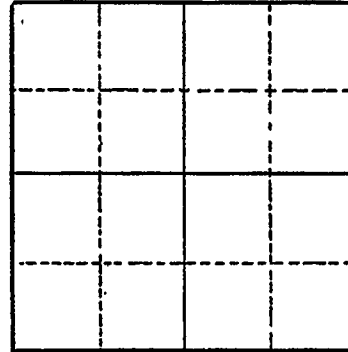

Section

Altitude at well

TYPE OF WELL: Drilled Date Constructed 1947

Depth drilled 65 Depth cased 65

### CASING RECORD:

6-inch

### FINISH:

### AQUIFERS:

Topsoil, hard pan, clay, sand and gravel

### WATER LEVEL:

25-feet

PUMPING EQUIPMENT: Type Jet H.P. 2  
Capacity 30 G.P.M.

### WELL TESTS:

Drawdown 30 ft. after hours Pumping 100 G.P.M.  
Drawdown 15 ft. after hours Pumping 30 G.P.M.

USE OF WATER Irrigation Temp. °F. 19

SOURCE OF INFORMATION GR-2446

### DRILLER or DIGGER

### ADDITIONAL DATA:

Log  Water Level Measurements  Chemical Analysis  Aquifer Test

### REMARKS:

|                   |    |    |
|-------------------|----|----|
| Topsoil           | 0  | 5  |
| Hard pan and clay | 5  | 20 |
| Sand and gravel   | 20 | 65 |

STATE ENGINEER  
Salem, Oregon

662  
W. 21

# Well Record

STATE WELL NO. 7/2W-5K(2)  
COUNTY Marion  
APPLICATION NO.

pg 2 of 2

OWNER: C. C. Reynolds

MAILING ADDRESS:

LOCATION OF WELL: Owner's No.

CITY AND STATE:

..... 1/4 ..... 1/4 Sec. .... T. .... N. E. S, R. .... W., W.M.


Bearing and distance from section or subdivision

corner .....

Altitude at well ..... 183 .....

TYPE OF WELL: Drilled Date Constructed 1947

Depth drilled ..... 65 ..... Depth cased ..... 65 .....

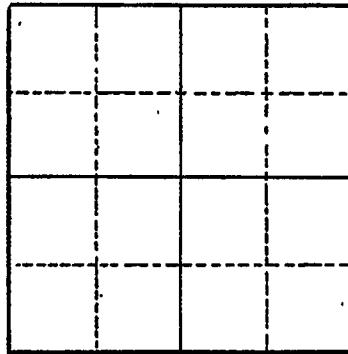

Section .....

### CASING RECORD:

6 inch

### FINISH:

### AQUIFERS:

Sand and gravel from 20 to 65

### WATER LEVEL:

25 feet below land surface on April 3, 1952

PUMPING EQUIPMENT: Type Jet H.P. 2  
Capacity G.P.M.

### WELL TESTS:

Drawdown ..... ft. after ..... hours ..... G.P.M.

Drawdown ..... ft. after ..... hours ..... G.P.M.

USE OF WATER Irrigation--2 acres Temp. °F., 19

SOURCE OF INFORMATION USGS

DRILLER or DIGGER

### ADDITIONAL DATA:

Log Water Level Measurements Chemical Analysis Aquifer Test

### REMARKS: