

STATE ENGINEER  
Salem, Oregon

# Well Record

STATE WELL NO. 7/2W-5K  
COUNTY MARION  
APPLICATION NO. GR-2620

*man  
6625*

OWNER: Neil Louis Emmons MAILING ADDRESS: 5440 Hayesville Drive *B lot 2*

LOCATION OF WELL: Owner's No. \_\_\_\_\_ CITY AND STATE: Salem, Oregon

NW 1/4 SE 1/4 Sec. 5 T. 7 S., R. 2 W., W.M.

Bearing and distance from section or subdivision  
corner S. 9° W. 2244.0' and N. 89° 49' W. 691.18' from  
the NE corner of the John Martin Donation Land Claim.


Altitude at well \_\_\_\_\_

TYPE OF WELL: Drilled Date Constructed 1954

Depth drilled 100 Depth cased 90+

Section \_\_\_\_\_

CASING RECORD:

6-inch

FINISH:

Yes

AQUIFERS:

Gravels

WATER LEVEL:

20-feet

PUMPING EQUIPMENT: Type Advance Electric H.P. 3  
Capacity 100 G.P.M.

WELL TESTS:

Drawdown 20 ft. after \_\_\_\_\_ hours Pumping 100 G.P.M.

Drawdown \_\_\_\_\_ ft. after \_\_\_\_\_ hours \_\_\_\_\_ G.P.M.

USE OF WATER Irrigation Temp. \_\_\_\_\_ °F. \_\_\_\_\_ 19

SOURCE OF INFORMATION GR-2487

DRILLER or DIGGER \_\_\_\_\_

ADDITIONAL DATA:

Log  Water Level Measurements \_\_\_\_\_ Chemical Analysis \_\_\_\_\_ Aquifer Test \_\_\_\_\_

REMARKS:

Gravels

STATE ENGINEER  
Salem, Oregon

# Well Record

mar  
6625

STATE WELL NO. 7/2W-5K(3)  
COUNTY Marion  
APPLICATION NO.

Pg 2 of 2

OWNER: N. L. Emmons


MAILING ADDRESS:

LOCATION OF WELL: Owner's No.

CITY AND STATE:

..... 1/4 ..... 1/4 Sec. T. N. E.  
S, R. W., W.M.

Bearing and distance from section or subdivision corner

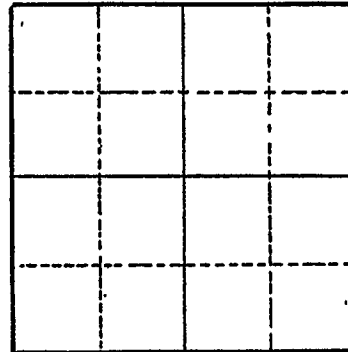

Altitude at well 183

TYPE OF WELL: Drilled Date Constructed 1954

Depth drilled 100 Depth cased

Section

CASING RECORD:

6 inch

FINISH:

AQUIFERS:

Gravel

WATER LEVEL:

20 feet below land surface, July, 1954

PUMPING EQUIPMENT: Type Jet H.P. 3  
Capacity G.P.M.

WELL TESTS:

Drawdown ft. after hours G.P.M.  
Drawdown ft. after hours G.P.M.

USE OF WATER Domestic, Irrigation-3 ac. Temp. °F. 19.

SOURCE OF INFORMATION USGS

DRILLER or DIGGER

ADDITIONAL DATA:

Log Water Level Measurements Chemical Analysis Aquifer Test

REMARKS: