

STATE ENGINEER  
Salem, Oregon

M 31... 6629

# Well Record


STATE WELL NO. 7/2W-5L(1)  
COUNTY Marion  
APPLICATION NO. GR-329

OWNER: John Jeffery  
MAILING ADDRESS: 5220 Hayeville Drive

LOCATION OF WELL: Owner's No. #1  
CITY AND STATE: Salem, Oregon

NE 1/4 SW 1/4 Sec. 5 T. 7 S. R. 2 W., W.M.

Bearing and distance from section or subdivision  
corner 2800 feet East and 3200 feet South of NW  
corner, Section 5

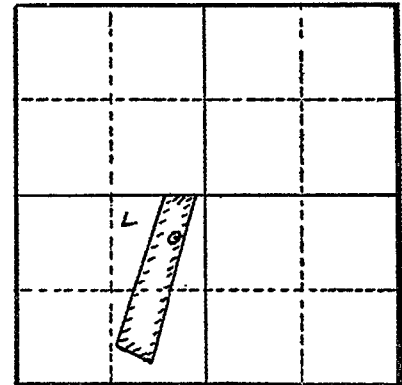

Section 5

Altitude at well 182 feet interpolated

TYPE OF WELL: Drilled Date Constructed July, 1950  
Depth drilled 73 feet Depth cased 70 feet

### CASING RECORD:

8-inch casing set from 0 to 70 feet

### FINISH:

perforated from 50 to 70 feet

### AQUIFERS:

unk

### WATER LEVEL:

50 feet below land surface

PUMPING EQUIPMENT: Type Berkeley H.P. 15  
Capacity 550 G.P.M.

### WELL TESTS:

Drawdown 25 ft. after \_\_\_\_\_ hours pumping 550 G.P.M.  
Drawdown \_\_\_\_\_ ft. after \_\_\_\_\_ hours \_\_\_\_\_ G.P.M.

USE OF WATER Irrigation 49 Temp. \_\_\_\_\_ °F., 19

SOURCE OF INFORMATION GR-311

DRILLER or DIGGER

### ADDITIONAL DATA:

Log no \_\_\_\_\_ Water Level Measurements \_\_\_\_\_ Chemical Analysis \_\_\_\_\_ Aquifer Test \_\_\_\_\_

### REMARKS: