

STATE ENGINEER  
Salem, Oregon

# Well Record

STATE WELL NO. 4/1W-21J(1)  
COUNTY Marion  
APPLICATION NO. GR-253


MARION 664

OWNER: Henry F. Pardey MAILING ADDRESS: \_\_\_\_\_

LOCATION OF WELL: Owner's No. 1 CITY AND STATE: Aurora, Oregon

NE 1/4 SE 1/4 Sec. 21 T. 4 N. S., R. 1 E. W., W.M.

Bearing and distance from section or subdivision corner 3211.32' E. & 568.25' S. from SW cor. Grimm DLC 49

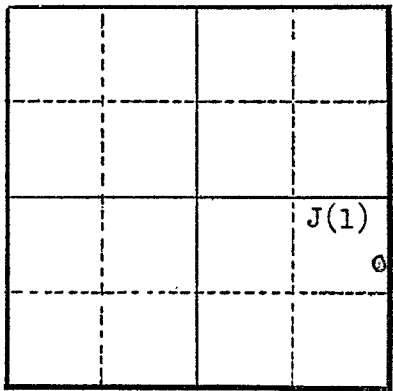

Section 21

Altitude at well 180' Interpolated

TYPE OF WELL: Drilled Date Constructed 8-7-51

Depth drilled 137 Depth cased 118

### CASING RECORD:

10 inch casing set from 0 to 118 feet

### FINISH:

unknown perforations from 110 to 117 feet

### AQUIFERS:

Sand and gravel 118 to 137 feet

### WATER LEVEL:

110 feet below land surface

PUMPING EQUIPMENT: Type Peerless Turbine H.P. 30  
Capacity 680 G.P.M.

### WELL TESTS:

Drawdown \_\_\_\_\_ ft. after \_\_\_\_\_ hours pumping 680 G.P.M.  
Drawdown \_\_\_\_\_ ft. after \_\_\_\_\_ hours \_\_\_\_\_ G.P.M.

USE OF WATER Irrigation 93.6 acres Temp. \_\_\_\_\_ °F. \_\_\_\_\_, 19\_\_\_\_

SOURCE OF INFORMATION Registration Statement GR-253

DRILLER or DIGGER J. T. Miller, Aurora, Oregon

### ADDITIONAL DATA:

Log Yes Water Level Measurements \_\_\_\_\_ Chemical Analysis \_\_\_\_\_ Aquifer Test \_\_\_\_\_

### REMARKS:

