

STATE ENGINEER
Salem, Oregon

Well Record

STATE WELL NO. 4/1W-21D(1)
COUNTY Marion
APPLICATION NO.

OWNER: George Koebel, Jr.

MAILING
ADDRESS:

LOCATION OF WELL: Owner's No.

CITY AND
STATE:

..... 1/4 1/4 Sec. T. N. S., R. E. W., W.M.

Bearing and distance from section or subdivision

corner


Altitude at well 160

TYPE OF WELL: Drilled Date Constructed 1954

Depth drilled 90 Depth cased 90

CASING RECORD:

8 inch

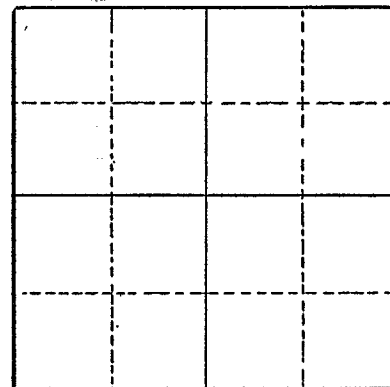

Section

FINISH:

Open bottom (casing unperforated)

AQUIFERS:

WATER LEVEL:

30 feet

PUMPING EQUIPMENT: Type Turbine H.P. 5
Capacity G.P.M.

WELL TESTS:

Drawdown ft. after hours G.P.M.

Drawdown ft. after hours G.P.M.

USE OF WATER Irrigation-10 acres Temp. °F. 19

SOURCE OF INFORMATION USGS

DRILLER or DIGGER

ADDITIONAL DATA:

Log Water Level Measurements Chemical Analysis Aquifer Test

REMARKS:

Bottom 15 ft. of well filled with gravel.