

STATE ENGINEER  
Salem, Oregon

6682  
MARI.....

# Well Record

STATE WELL NO. 7/2W-6E  
COUNTY MARION  
APPLICATION NO. GR-4103

OWNER: Clarence W. Hill


MAILING ADDRESS: 5045 Portland Rd

LOCATION OF WELL: Owner's No.

CITY AND STATE: Salem, Oregon

SW 1/4 NW 1/4 Sec. 6 T. 7 S., R. 2 W., W.M.

Bearing and distance from section or subdivision corner 300' E & 270' N from W 1/4 Sec 6

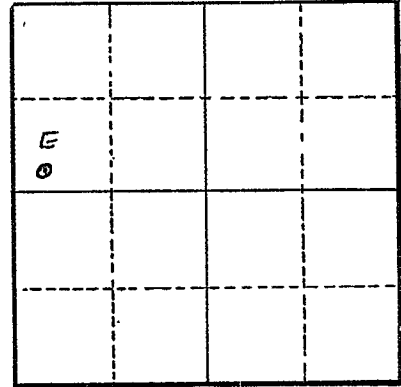

Section 6

Altitude at well

TYPE OF WELL: Drilled Date Constructed 1953

Depth drilled 80' Depth cased 78'

CASING RECORD:

6-inch

FINISH:

AQUIFERS:

WATER LEVEL:

50'

PUMPING EQUIPMENT: Type Jet Pump

H.P. 3

Capacity 50 G.P.M.

WELL TESTS:

Drawdown ft. after hours 50 G.P.M.

Drawdown ft. after hours G.P.M.

USE OF WATER Irrigation

Temp. °F. 19

SOURCE OF INFORMATION GR-3936

DRILLER or DIGGER Dat Saunders

ADDITIONAL DATA:

Log NA Water Level Measurements Chemical Analysis Aquifer Test

REMARKS: