

STATE ENGINEER
Salem, Oregon

MARI 6683

MARI 6683
Well Record

STATE WELL NO. 7/2W-6E(1)
COUNTY Marion
APPLICATION NO.

OWNER: Fred McLain


MAILING
ADDRESS:

LOCATION OF WELL: Owner's No.

CITY AND
STATE:

..... 1/4 1/4 Sec. T. N. E.
..... S., R. W., W.M.

Bearing and distance from section or subdivision
corner

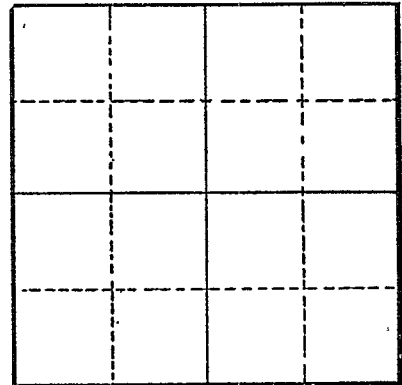

Section

Altitude at well 185

TYPE OF WELL: Drilled.... Date Constructed 1958

Depth drilled 127 Depth cased 127

CASING RECORD:

8 inch

FINISH:

Casing perforated from 80 to 119

AQUIFERS:

Sand from 68 to 70
Gravel from 78 to 79 and 126 to 127

WATER LEVEL:

52 feet below land surface on October 18, 1958

PUMPING EQUIPMENT: Type Turbine H.P. 15

Capacity G.P.M.

WELL TESTS:

Drawdown ft. after hours G.P.M.

Drawdown ft. after hours G.P.M.

USE OF WATER Public Supply Temp. °F., 19

SOURCE OF INFORMATION USGS

DRILLER or DIGGER

ADDITIONAL DATA:

Log^X..... Water Level Measurements Chemical Analysis Aquifer Test

REMARKS:

Supplies small housing development.
Temperature 55° F.



Oregon Water Resources Department
725 Summer Street NE, Suite A
Salem Oregon 97301
(503) 986-0900
www.wrd.state.or.us

Application for
Well ID Number

RECEIVED

FEB 06 2014

WATER RESOURCES DEPT
SALEM, OREGON

Do not complete if the well already has a Well I.D. Number.

I. OWNER INFORMATION

Current Owner Name (please print): MCLAIN Village Water Dept. INC.
Mailing Address: 4898 38th PLACE NE
City, State, Zip: SALEM OR 97305
Address to send Well I.D. Tag:
City, State, Zip:

II. WELL INFORMATION (Do not complete this section if the well report is attached.)

Township: (North/South) Range: (East/West) Section:
Tax Lot: County 1/4 1/4
Street Address of Well, City:
Owner at time the well was constructed, (if known):
If the property had a different street address in the past:

III. GENERAL WELL INFORMATION (Do not complete this section if the well report is attached)

Use of Well (domestic, irrigation, commercial, industrial, monitoring):
Date Well Constructed: Total Well Depth: Casing Diameter:
Other Information: MARI 4777 + MARI 6683

SUBMITTED BY (please print): Linda Hood
PHONE: 503-949-0828 OR 503-949-6932 FAX: -

Send application to Oregon Water Resources Department; 725 Summer St NE, Suite A; Salem, Oregon 97301-1266; fax (503) 986-0902. Applications are processed and Well I.D. Numbers are mailed every Wednesday.

For Official Use Only by the Oregon Water Resources Department:
Received Date: 2-6-14
Well Log Number: MARI 4777 orig
MARI 6683
Well:
Identification #: L-114123