

STATE ENGINEER
Salem, Oregon


M 71...
6689

Well Record

STATE WELL NO. 7/2W-6G(1)
COUNTY Marion
APPLICATION NO. GR-753

OWNER: Burns & Ethel Christofferson
MAILING ADDRESS: 4420 Hood View Road
CITY AND STATE: Salem, Oregon

LOCATION OF WELL: Owner's No. 1
SW 1/4 NE 1/4 Sec. 6 T. 7 S., R. 2 W., W.M.

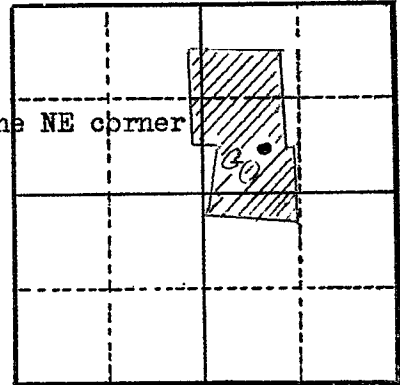

Bearing and distance from section or subdivision
corner 29.91 chains South and 24.61 chains West from the NE corner
of Section 6.

Section 6

Altitude at well 184 feet interpolated

TYPE OF WELL: Drilled Date Constructed 1948

Depth drilled 117.5 feet Depth cased 117.5 feet

CASING RECORD:

8 inch casing set from 0 to 117.5 feet

FINISH:

perforated from 70 to 117 feet

AQUIFERS:

sand and gravel 45 to 117.5 feet

WATER LEVEL:

37 feet

PUMPING EQUIPMENT: Type 3 phase electric - Berkeley deep well H.P. 10
Capacity G.P.M.

WELL TESTS:

Drawdown 39 ft. after 300 hours G.P.M.
Drawdown ft. after hours G.P.M.

USE OF WATER Irrigation 64 Temp. °F., 19

SOURCE OF INFORMATION GR-729

DRILLER or DIGGER Wymore, Brooks

ADDITIONAL DATA:

Log X Water Level Measurements Chemical Analysis Aquifer Test

REMARKS:

Willamette Loam	0	2	2
Clay	2	32	30
Sand	32	33.3	1.3
Sand and Gravel	33.3	117.5	84.2