


STATE ENGINEER
Salem, Oregon

6690
MAR 21 1951
Well Record

STATE WELL NO. 7/2W-6K(1)
COUNTY Marion
APPLICATION NO. GR-324

OWNER: Sam Schirman
MAILING ADDRESS: 4540 Haysville Drive
CITY AND STATE: Salem, Oregon

LOCATION OF WELL: Owner's No. 1
NW 1/4 SE 1/4 Sec. 6 T. 7 S. R. 2 W., W.M.
Bearing and distance from section or subdivision
corner 1900 feet West and 1600 feet North from
SE corner, Section 6

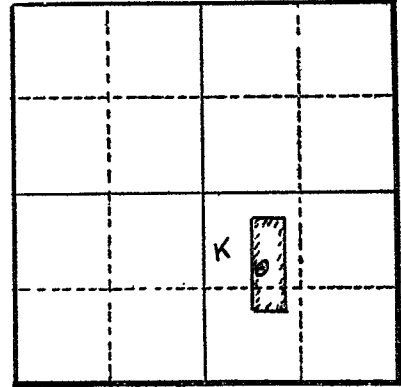

Section 6

Altitude at well 183 feet interpolated

TYPE OF WELL: Drilled Date Constructed Oct. 1951

Depth drilled 120 feet Depth cased 120 feet

CASING RECORD:

8-inch casing set from 0 to 120 feet

FINISH:

12 perforations per foot set from 85 to 119 feet

AQUIFERS:

gravel and sand between 64 and 119 feet

WATER LEVEL:

22 feet below land surface 11-16-51

PUMPING EQUIPMENT: Type Berkeley Turbine 3 phase H.P. 10
Capacity 200 G.P.M.

WELL TESTS:

Drawdown 34 ft. after pumping 375 hours G.P.M.
Drawdown ft. after hours G.P.M.

USE OF WATER Irrigation 13 Temp. °F., 19

SOURCE OF INFORMATION GR-306

DRILLER or DIGGER

ADDITIONAL DATA:

Log x Water Level Measurements Chemical Analysis Aquifer Test

REMARKS:

Top soil	0	3	3	Gravel and shale	53	64	11
Brown soil	3	12	9	Gravel, tight	64	75	11
Shale, brown sandy	12	34	22	Shale	75	85	10
Shale, blue	34	53	19	Sand and gravel	85	119	34