

STATE ENGINEER
Salem, Oregon

MARK 694 Well Record

GR- 1781

STATE WELL NO. 7/2W-6M (2)
COUNTY Marion
APPLICATION NO. GR- 1836

OWNER: Werner J. Jarms


MAILING ADDRESS: 5110 Portland Rd.

LOCATION OF WELL: Owner's No.

CITY AND STATE: Salem, Oregon

NW 1/4 SW 1/4 Sec. 6 T. 7 S., R. 2 W., W.M.

Bearing and distance from section or subdivision corner 600' N. & 170' E. from most Westerly SW cor. of A. Stanton DLG #49

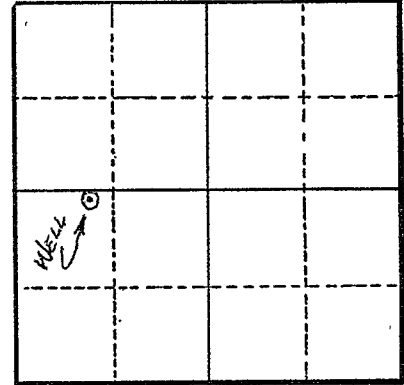

Section 6

Altitude at well 175' ? 182'

TYPE OF WELL: Drilled Date Constructed 1952

Depth drilled 90' Depth cased 90'

CASING RECORD:
6"

FINISH:

AQUIFERS:

Sand & gravel

WATER LEVEL:

46' March, 1952

PUMPING EQUIPMENT: Type Berkeley turbine H.P. 2

Capacity 30 G.P.M.

WELL TESTS:

Drawdown ft. after hours G.P.M.

Drawdown ft. after hours G.P.M.

USE OF WATER Irrigation Temp. °F. 19

SOURCE OF INFORMATION GR Record

DRILLER or DIGGER

ADDITIONAL DATA:

Log Water Level Measurements Chemical Analysis Aquifer Test

REMARKS:

Log: Clay 0 to 45 ft.
Sand & some gravel 45 to 50 ft. (water)
Yellow clay & some blue clay 50 to 75 ft.
Sand & gravel 75 to 90 ft.
Water from 75 to 90 ft.

Irrigation of 7 acres.