

STATE ENGINEER
Salem, Oregon

MARI 672

Well Record

STATE WELL NO. 4/1W-21P(1)
COUNTY Marion
APPLICATION NO. GR 2370


OWNER: R. H. Bassett

MAILING ADDRESS:
CITY AND STATE:

LOCATION OF WELL: Owner's No.

..... 1/4 1/4 Sec. T. N. S, R. E. W., W.M.

Bearing and distance from section or subdivision corner

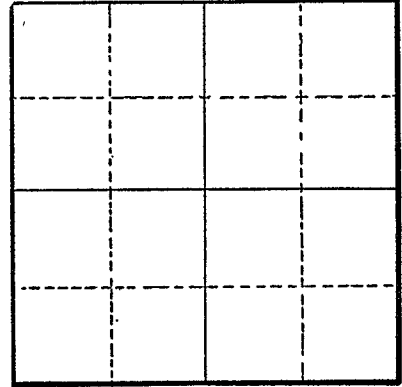

Section

Altitude at well 180

TYPE OF WELL: Drilled Date Constructed 1952

Depth drilled 128 Depth cased 128

CASING RECORD:

10 inch

FINISH:

Casing perforated 120 to 126

AQUIFERS:

Gravel from 120 to 126

WATER LEVEL:

34.60 feet below land surface on February 3, 1960

PUMPING EQUIPMENT: Type Turbine H.P. 5
Capacity G.P.M.

WELL TESTS:

Drawdown ft. after hours G.P.M.
Drawdown ft. after hours G.P.M.

USE OF WATER Irrigation--59 acres Temp. °F., 19

SOURCE OF INFORMATION USGS

DRILLER or DIGGER

ADDITIONAL DATA:

Log Water Level Measurements Chemical Analysis Aquifer Test

REMARKS: