

STATE ENGINEER
Salem, Oregon

MA 716774 Well Record

STATE WELL NO. 7/2W-7H(1)
COUNTY Marion
APPLICATION NO. GR-730
(4665)?

OWNER: Robert Andrew Fiedler


MAILING ADDRESS: 4745 Satter Drive

LOCATION OF WELL: Owner's No. #1

CITY AND STATE: Salem, Oregon

SE 1/4 NE 1/4 Sec. 7 T. 7 S., R. 2 W., W.M.

Bearing and distance from section or subdivision corner 990 feet East and 1000 feet North from NW corner of Herron DLC 48

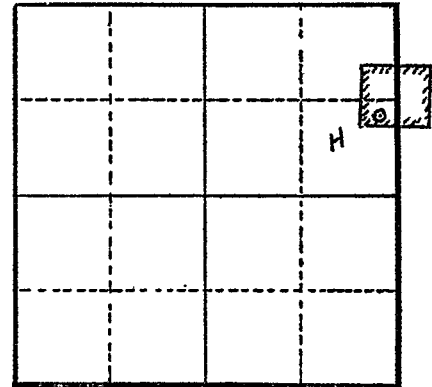

Section 7

Altitude at well 220 feet interpolated

TYPE OF WELL: Drilled Date Constructed 7-6-55

Depth drilled 133 feet Depth cased 133 feet

CASING RECORD:

10-inch standard black pipe 31.20#
surface to 133 feet

FINISH:

perforated 99 to 133

AQUIFERS:

coarse gravel from 99 to 133

WATER LEVEL:

21 feet 7-6-55

PUMPING EQUIPMENT: Type Elect. - Jacuzzi Turbine 4 in. H.P. 15
Capacity 240 G.P.M.

WELL TESTS:

Drawdown 66 ft. after 545 hours G.P.M.
Drawdown 17 ft. after 200 hours G.P.M.

USE OF WATER Irrigation 13 Temp. °F., 19

SOURCE OF INFORMATION GR-706

DRILLER or DIGGER

ADDITIONAL DATA:

Log Water Level Measurements Chemical Analysis Aquifer Test

REMARKS:

