

STATE ENGINEER
Salem, Oregon

6807
MARION

Well Record

STATE WELL NO. 7/2W-8E(1)
COUNTY Marion
APPLICATION NO. GR-1603

GR-1555

OWNER: L. A. Tunnell


MAILING ADDRESS: 4145 Schafer Ave.

LOCATION OF WELL: Owner's No.

CITY AND STATE: Salem, Oregon

SW 1/4 NW 1/4 Sec. 8 T. 7 S., R. 2 W., W.M.

Bearing and distance from section or subdivision corner 1900' S. & 1090' E. from NW cor. Sec. 8

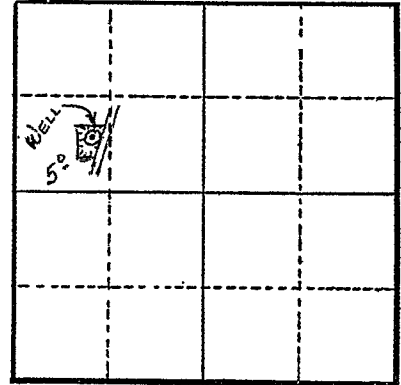

Section 8

Altitude at well 180'

TYPE OF WELL: Drilled Date Constructed Prior to 1950

Depth drilled 65' Depth cased

CASING RECORD:

6"

FINISH:

Perforated

AQUIFERS:

WATER LEVEL:

18'

PUMPING EQUIPMENT: Type Cent. jet H.P. 1
Capacity 35 G.P.M.

WELL TESTS:

Drawdown 24 ft. after 20 hours G.P.M.

Drawdown ft. after hours G.P.M.

USE OF WATER Irrigation Temp. °F., 19

SOURCE OF INFORMATION GR Record

DRILLER or DIGGER

ADDITIONAL DATA:

Log N.A. Water Level Measurements Chemical Analysis Aquifer Test

REMARKS:

Irrigation of 5 acres.