

STATE ENGINEER  
Salem, Oregon

M 1716809

# Well Record

STATE WELL NO. 7/2W-8F(1)  
COUNTY Marion  
APPLICATION NO. GR-1322

GR- 1277

OWNER: John Schafer


MAILING ADDRESS: 4190 Schafer Ave.

LOCATION OF WELL: Owner's No.

CITY AND STATE: Salem, Oregon

SE 1/4 NW 1/4 Sec. 8 T. 7 N. S., R. 2 E. W., W.M.

Bearing and distance from section or subdivision corner 1700' E. & 1480' S. from NW cor. Sec. 8

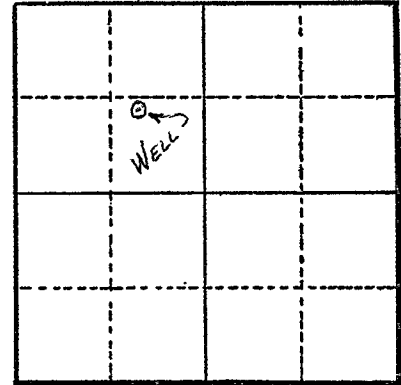

Section 8

Altitude at well 180'

TYPE OF WELL: Drilled Date Constructed 1951

Depth drilled 69 ft. Depth cased 69 ft.

### CASING RECORD:

6 inch

### FINISH:

### AQUIFERS:

### WATER LEVEL:

12 ft.

PUMPING EQUIPMENT: Type Jacuzzi Jet H.P. 2

Capacity 40 G.P.M.

### WELL TESTS:

Drawdown ft. after hours G.P.M.

Drawdown ft. after hours G.P.M.

USE OF WATER Irrigation Temp. °F. 19

SOURCE OF INFORMATION G. R. Record

DRILLER or DIGGER

### ADDITIONAL DATA:

Log N.A. Water Level Measurements Chemical Analysis Aquifer Test

### REMARKS:

Irrigation of 6 acres.