

STATE ENGINEER  
Salem, Oregon

MARI...  
6810

# Well Record

STATE WELL NO. 7/2W-8F(2)  
COUNTY Marion  
APPLICATION NO. \_\_\_\_\_

OWNER: G. D. Yarnell


MAILING ADDRESS: \_\_\_\_\_

LOCATION OF WELL: Owner's No. \_\_\_\_\_

CITY AND STATE: \_\_\_\_\_

..... 1/4 ..... 1/4 Sec. .... T. .... N. E.  
S., R. .... W., W.M.

Bearing and distance from section or subdivision corner \_\_\_\_\_

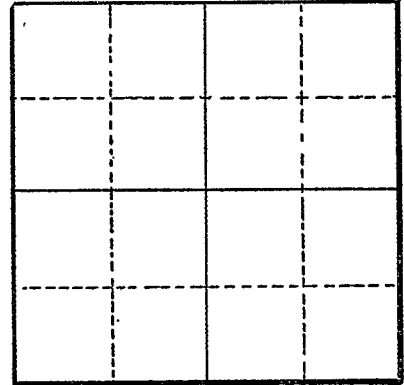

Section \_\_\_\_\_

Altitude at well 178

TYPE OF WELL: Drilled Date Constructed 1949

Depth drilled 110 Depth cased \_\_\_\_\_

CASING RECORD:

6 inch

FINISH:

AQUIFERS:

WATER LEVEL:

PUMPING EQUIPMENT: Type Jet H.P. 1  
Capacity \_\_\_\_\_ G.P.M.

WELL TESTS:

Drawdown \_\_\_\_\_ ft. after \_\_\_\_\_ hours \_\_\_\_\_ G.P.M.  
Drawdown \_\_\_\_\_ ft. after \_\_\_\_\_ hours \_\_\_\_\_ G.P.M.

USE OF WATER Domestic Irrigation 5 ac. Temp. \_\_\_\_\_ °F. \_\_\_\_\_, 19\_\_\_\_

SOURCE OF INFORMATION USGS

DRILLER or DIGGER \_\_\_\_\_

ADDITIONAL DATA:

Log \_\_\_\_\_ Water Level Measurements \_\_\_\_\_ Chemical Analysis \_\_\_\_\_ Aquifer Test \_\_\_\_\_

REMARKS: