

STATE ENGINEER
Salem, Oregon

MAR 1968

Well Record

STATE WELL NO. 7/2W-8D(1)
COUNTY Marion
APPLICATION NO. GR-147

OWNER: J. F. and Stella Abbott


MAILING ADDRESS: 4203 Schafer Avenue

LOCATION OF WELL: Owner's No. # 1

CITY AND STATE: Salem, Oregon

NW 1/4 NW 1/4 Sec. 8 T. 7 S., R. 2 W., W.M.

Bearing and distance from section or subdivision
corner 830 feet South and 1200 feet East from
NW 1/4 Corner, Section 8

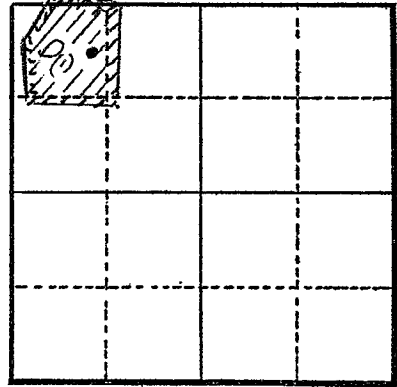

Section 8

Altitude at well 176 feet interpolated

TYPE OF WELL: Drilled Date Constructed 10-15-51

Depth drilled 138 feet Depth cased 138 feet

CASING RECORD:

8-inch steel casing set from 0 to 138 feet

FINISH:

knife slots set from 82 to 138 feet

AQUIFERS:

unk

WATER LEVEL:

20 feet below land surface 11-6-51

PUMPING EQUIPMENT: Type Turbine H.P. 20
Capacity G.P.M.

WELL TESTS:

Drawdown 110 ft. after hours pumping 220 G.P.M.
Drawdown 110 ft. after hours " 240 G.P.M.

USE OF WATER Irrigation 37 Temp. °F. , 19

SOURCE OF INFORMATION GR-141

DRILLER or DIGGER

ADDITIONAL DATA:

Log no Water Level Measurements Chemical Analysis Aquifer Test

REMARKS: