

STATE ENGINEER  
Salem, Oregon

**Well Record**  
MARI...  
6874


STATE WELL NO. 7/2W-8L(1)  
COUNTY Marion  
APPLICATION NO. GR-632

OWNER: Alice M. Beardsley  
MAILING ADDRESS: 5040 Herrin Road

LOCATION OF WELL: Owner's No. \_\_\_\_\_  
CITY AND STATE: Salem, Oregon

NW 1/4 SW 1/4 Sec. 8 T. 7 S. R. 2 W., W.M.

Bearing and distance from section or subdivision  
corner 2400 feet North and 200 feet West of  
SW corner, Section 8

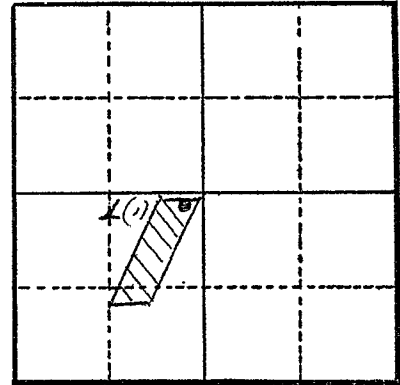

Section 8

Altitude at well 180 feet interpolated

TYPE OF WELL: Drilled Date Constructed March 1952  
Depth drilled 116 feet Depth cased 116 feet

CASING RECORD:

8 1/2 inch

FINISH:

AQUIFERS:

WATER LEVEL:

PUMPING EQUIPMENT: Type Berkeley Turbines H.P. 15  
Capacity 180 G.P.M.

WELL TESTS:

Drawdown \_\_\_\_\_ ft. after \_\_\_\_\_ hours \_\_\_\_\_ G.P.M.  
Drawdown \_\_\_\_\_ ft. after \_\_\_\_\_ hours \_\_\_\_\_ G.P.M.

USE OF WATER Irrigation 20 Temp. \_\_\_\_\_ °F. \_\_\_\_\_, 19.

SOURCE OF INFORMATION GR-596

DRILLER or DIGGER \_\_\_\_\_

ADDITIONAL DATA:

Log  Water Level Measurements \_\_\_\_\_ Chemical Analysis \_\_\_\_\_ Aquifer Test \_\_\_\_\_

REMARKS:

Topsoil and blue clay	0	60	60
Muddy sand	60	78	18
Sand and gravel	78	81	3
Gray clay	81	98	17
Sand and gravel	98	116	18