

STATE ENGINEER  
Salem, Oregon

MAR 1949 **Well Record**


STATE WELL NO. 7/2W-9B  
COUNTY MARION  
APPLICATION NO. GR-3288

OWNER: Roy S. Scofield  
MAILING ADDRESS: 6566 Silverton Rd

LOCATION OF WELL: Owner's No. \_\_\_\_\_  
CITY AND STATE: Oregon

NW 1/4 NE 1/4 Sec. 9 T. 7 S., R. 2 W., W.M.

Bearing and distance from section or subdivision  
corner 5 miles NE of Salem Oregon

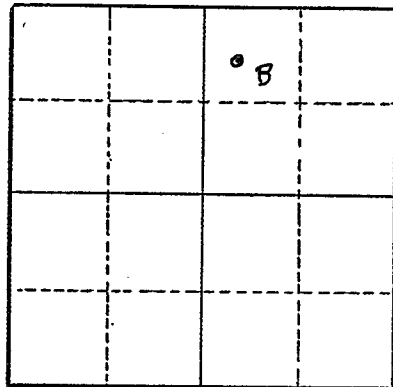

Section 9

Altitude at well \_\_\_\_\_

TYPE OF WELL: Drilled Date Constructed 1949

Depth drilled 28' Depth cased \_\_\_\_\_

CASING RECORD:

6-inch

FINISH:

AQUIFERS:

WATER LEVEL:

28'

PUMPING EQUIPMENT: Type Jazusic H.P. 2  
Capacity 45 G.P.M.

WELL TESTS:

Drawdown 50 ft. after \_\_\_\_\_ hours 65 G.P.M.

Drawdown \_\_\_\_\_ ft. after \_\_\_\_\_ hours \_\_\_\_\_ G.P.M.

USE OF WATER Irrigation Temp. \_\_\_\_\_ °F. \_\_\_\_\_, 19\_\_\_\_\_

SOURCE OF INFORMATION GR-3894

DRILLER or DIGGER \_\_\_\_\_

ADDITIONAL DATA:

Log  Water Level Measurements \_\_\_\_\_ Chemical Analysis \_\_\_\_\_ Aquifer Test \_\_\_\_\_

REMARKS:

No log was kept that I know of. I do know they hit a line Rock of slate at 60' then sand 10' & then gravel that where they stopped.