

STATE ENGINEER
Salem, Oregon

MARI. 696

Well Record

STATE WELL NO. 4/W-22D
COUNTY MARION
APPLICATION NO. GR-2786

OWNER: Claud E. Beckwith

MAILING ADDRESS: 468 Garfield St.


B of 3

LOCATION OF WELL: Owner's No.

CITY AND STATE: Woodburn, Oregon

NW 1/4 NW 1/4 Sec. 22 T. 4 N. S. R. 1 E. W., W.M.

Bearing and distance from section or subdivision corner 1050' E. and 150' S.

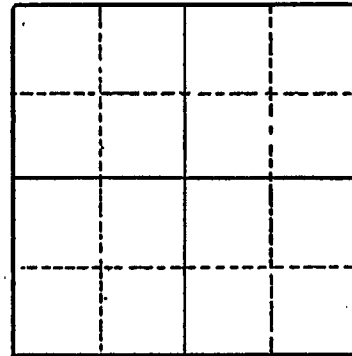

Section

Altitude at well

TYPE OF WELL: drilled Date Constructed 1947

Depth drilled 96 Depth cased 96

CASING RECORD:

6-inch

FINISH:

AQUIFERS:

Surface, clay and gravel and sand

WATER LEVEL:
35-feet

PUMPING EQUIPMENT: Type Fairbanks Morse H.P. 1
Capacity 40 G.P.M.

WELL TESTS:
Drawdown 28 ft. after hours Pumping 45 G.P.M.
Drawdown ft. after hours G.P.M.

USE OF WATER irrigation Temp. °F. 19

SOURCE OF INFORMATION GR-2633

DRILLER or DIGGER

ADDITIONAL DATA:

Log Water Level Measurements Chemical Analysis Aquifer Test

REMARKS:

Surface	0	3
Sandy clay	3	65
Blue clay	65	70
Sandy clay grey	70	90
Sand	90	92
Small gravel	92	96

STATE ENGINEER
Salem, Oregon

MAR 16 1966

Well Record

STATE WELL NO. 4/1W-22D(1).
COUNTY Marion
APPLICATION NO.

OWNER: C. E. Beckwith


MAILING ADDRESS: Pg 2 of 3

LOCATION OF WELL: Owner's No.

CITY AND STATE:

..... 1/4 1/4 Sec. T. N. S, R. E. W., W.M.

Bearing and distance from section or subdivision corner

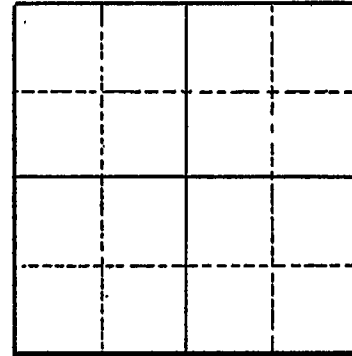

Section

Altitude at well 170

TYPE OF WELL: Drilled.. Date Constructed 1947

Depth drilled 96 Depth cased 96

CASING RECORD:
6 inch

FINISH:

AQUIFERS:

Fine gravel from 92 to 96

WATER LEVEL:

35 feet

PUMPING EQUIPMENT: Type Jet H.P. 1
Capacity G.P.M.

WELL TESTS:

Drawdown ft. after hours G.P.M.

Drawdown ft. after hours G.P.M.

USE OF WATER Domestic.. Irrigation 2.25 ac Temp. °F. , 19

SOURCE OF INFORMATION USGS

DRILLER or DIGGER

ADDITIONAL DATA:

Log Water Level Measurements Chemical Analysis Aquifer Test

REMARKS:

